

EFFECTIVE DATE: 9-19-90

FORM MUST BE TYPED
FORM C-1 4/90

State of Kansas
NOTICE OF INTENTION TO DRILL

FORM MUST BE SIGNED
ALL BLANKS MUST BE FILLED

Must be approved by the K.C.C. five (5) days prior to commencing well

Expected Spud Date 9 24 1990
month day year

APP NW SE Sec 14 Twp 34 S, Rg 20 East West

OPERATOR: License # 3882
Name: Samuel, Gary, Jr., & Associates, Inc.
Address: 1775 Sherman Street, Suite 1925
City/State/Zip: Denver, CO 80203
Contact Person: Dan Hall (303)628-3800
Phone: 303/831-4673

2080' feet from south line of Section
1980' feet from East line of Section
(Note: Locate well on Section Plat on Reverse Side)

CONTRACTOR: License # 7345
Name: Triad Drilling Rig #19

County: Comanche
Lease Name: Lemon Well #: 14-10
Field Name: Lemon Ranch
Is this a Prorated Field? yes no
Target Formation(s): Viola
Nearest lease or unit boundary: 560
Ground Surface Elevation: 1755 feet MSL
Domestic well within 330 feet: yes no
Municipal well within one mile: yes no
Depth to bottom of fresh water: 100 ft
Depth to bottom of usable water: 220
Surface Pipe by Alternate: 1 2
Length of Surface Pipe Planned to be set: 650 ft
Length of Conductor pipe required: 80
Projected Total Depth: 650 ft
Formation at Total Depth: Arbuckle
Water Source for Drilling Operations:
... well ... farm pond other

Well Drilled For: Well Class: Type Equipment:
 Oil ... Inj Infield Mud Rotary
... Gas ... Storage Pool Ext. ... Air Rotary
... OWWO ... Disposal ... Wildcat ... Cable
... Seismic; ... # of Holes

If OWWO: old well information as follows:
Operator: _____
Well Name: _____
Comp. Date: _____ Old Total Depth _____

Directional, Deviated or Horizontal wellbore? ... yes no
If yes, total depth location: _____

DWR Permit #: _____
Will Cores Be Taken?: ... yes no
If yes, proposed zone: _____

AFFIDAVIT

The undersigned hereby affirms that the drilling, completion and eventual plugging of this well will comply with K.S.A. 55-101, et. seq.

It is agreed that the following minimum requirements will be met:

1. The appropriate district office shall be notified before setting surface pipe;
2. The minimum amount of surface pipe as specified above shall be set by circulating cement to the top; in all cases surface pipe shall be set through all unconsolidated materials plus a minimum of 20 feet into the underlying formation;
3. If the well is dry, a plugging proposal shall be submitted to the district office. An agreement between the operator and the district office on plug length and placement is necessary prior to plugging;
4. The appropriate district office will be notified before well is either plugged or production casing is cemented in;
5. If an Alternate II completion, production pipe shall be cemented from below any usable water to surface within 120 days of spud date. In all cases, notify district office prior to any cementing.

I hereby certify that the statements made herein are true and to the best of my knowledge and belief.

Date: 9/7/90 Signature of Operator or Agent: Dan Hall Title: Operations Manager

FOR KCC USE:
20792
API # 15- 033-20-452-0000
Conductor pipe required None feet
Minimum surface pipe required 650 feet per Alt. 1
Approved by: mlw 9-14-90
EFFECTIVE DATE: 9-19-90
This authorization expires: 3-14-91
(This authorization void if drilling not started within 6 months of effective date.)
Spud date: _____ Agent: _____

RECEIVED
STATE CORPORATION
SEP 11 1990
7-11-90
CONSERVATION DIVISION
Wichita, Kansas

14
34
2000

REMEMBER TO:

- File Drill Pit Application (form CDP-1) with Intent to Drill;
- File Completion Form ACO-1 within 120 days of spud date;
- File acreage attribution plat according to field proration orders;
- Notify appropriate district office 48 hours prior to workover or re-entry;
- Submit plugging report (CP-4) after plugging is completed;
- Obtain written approval before disposing or injecting salt water.


PLAT OF ACREAGE ATTRIBUTABLE TO A WELL

State Corporation Commission, Conservation Division
200 Colorado Derby Bldg. Wichita, Kansas 67202

OPERATOR Samuel Gary Jr. & Associates LOCATION OF WELL:
 LEASE Lemon 2080 feet north of SE corner
 WELL NUMBER #14-10 1980 feet west of SE corner
 FIELD Lemon Ranch NW SE Sec. 14 T 34S R 20 E/W
 COUNTY Comanche
 NO. OF ACRES ATTRIBUTABLE TO WELL 40 IS SECTION X REGULAR IRREGULAR?
 IF IRREGULAR, LOCATE WELL FROM NEAREST
 DESCRIPTION OF ACREAGE Sec. 14 SE/4 CORNER BOUNDARY.
 Beneath the base of Mississippian formation.

NOTE: If plat depicted is insufficient for your circumstances, you may attach your own scaled or surveyed plat.

PLAT

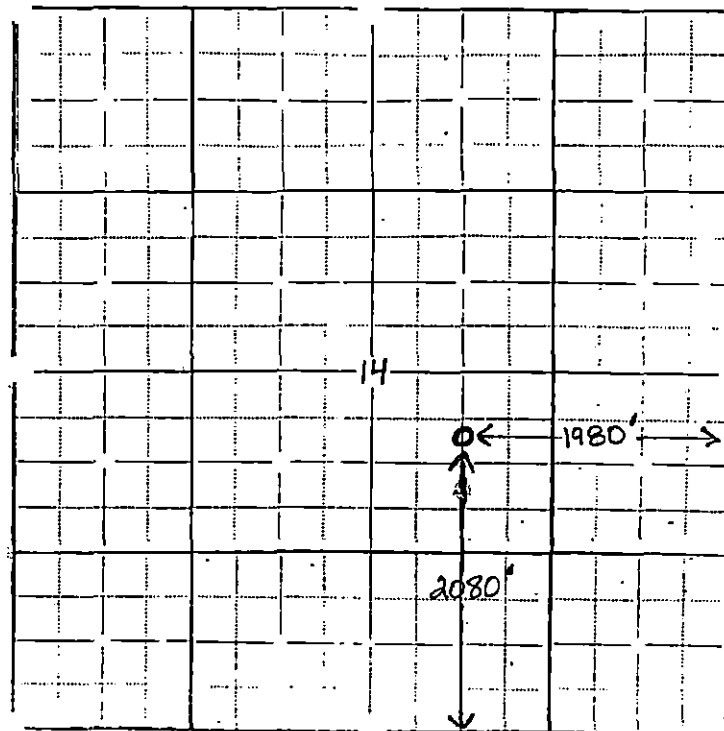

In plotting the proposed location of the well, you must show:

- 1) The manner in which you are using the depicted plat by identifying section lines, i.e. 1 section, 1 section with 8 surrounding partial sections, 4 sections, 16 sections, etc.;
- 2) the well's location relative to the location of other wells producing from the same common source of supply in adjoining drilling units, pursuant to K.A.R. 82-3-108, 82-3-207, 82-3-312, or special orders of the Commission;
- 3) the distance of the proposed drilling location from the section's east and south lines; and
- 4) the distance to the nearest lease or unit boundary line.

I hereby certify that the statements made herein are true and to the best of my knowledge and belief.

Signature of Operator or Agent Dan Hall
 Date 9/7/90 Title Operations Manager