

CARD MUST BE TYPED



# NOTICE OF INTENTION TO DRILL

State of Kansas  
(see rules on reverse side)

CARD MUST BE SIGNED

Starting Date: ..... March 21 1985 .....  
month day year

API Number 15- 033-20,296-~~1443~~-00-01

OPERATOR: License # 6420  
Name K.R.M. PETROLEUM CORPORATION  
Address 1900 Grant Street, Suite 300  
City/State/Zip Denver, Colorado 80203  
Contact Person James Alan Townsend  
Phone 303/830-6601

..... SW SE Sec 14 Twp 34 S, Rge 20  
(location)  East  West  
660 Ft North from Southeast Corner of Section  
1980 Ft West from Southeast Corner of Section  
(Note: Locate well on Section Plat on reverse side)

CONTRACTOR: License # 5829  
Name Aldebaran Drilling Co., Inc.  
City/State Wichita, Kansas 67218-0611

Nearest lease or unit boundary line 660' feet.  
County Comanche  
Lease Name Lemon Well# 4  
Domestic well within 330 feet:  yes  no  
Municipal well within one mile:  yes  no

Well Drilled For: Well Class: Type Equipment:  
 Oil  Swd  Infield  Mud Rotary  
 Gas  Inj  Pool Ext.  Air Rotary  
 OWWO  Expl  Wildcat  Cable

Depth to Bottom of fresh water 200 feet  
Lowest usable water formation Dakota  
Depth to Bottom of usable water 129-200 feet  
Surface pipe by Alternate:  1  2  
Surface pipe ~~Se~~ set 783' feet  
Conductor pipe if any required 60' feet  
Ground surface elevation 1754' feet MSL  
This Authorization Expires 7-4-85  
Approved By 3-4-85 *Ra*

If OWWO: old well info as follows:  
Operator K.R.M. PETROLEUM CORPORATION  
Well Name Lemon #4  
Comp Date 4/20/79 Old Total Depth 4830'  
Projected Total Depth 5350' feet  
Projected Formation at TD Mississippi  
Expected Producing Formations Mississippi

I certify that we will comply with K.S.A. 55-101, et seq., plus eventually plugging hole to K.C.C. specifications.

Date 2/28/85 Signature of Operator or Agent *[Signature]*


Title Vice President-Operations

MHC/KAPHE 3-4-85

Must be filed with the K.C.C. five (5) days prior to commencing well  
This card void if plugging not started within six (6) months of date received by K.C.C.  
RECEIVED  
STATE CORPORATION COMMISSION

A Regular Section of Land  
1 Mile = 5,280 Ft.

RECEIVED  
MAR 04 1985  
3-4-85  
CONSERVATION DIVISION  
Wichita, Kansas

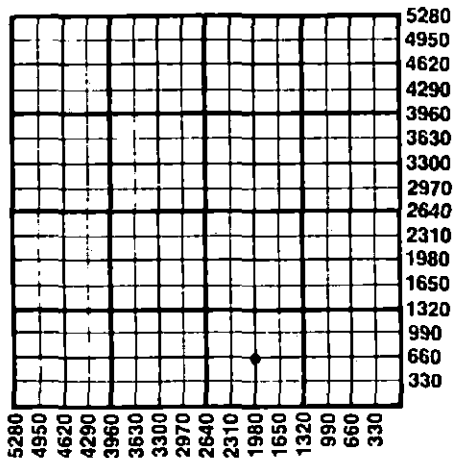

Important procedures to follow :

1. Notify District office before setting surface casing.
2. Set surface casing by circulating cement to the top.
3. File completion forms ACO-1 with K.C.C. within 90 days of well completion, following instructions on ACO-1, side 1, and including copies of wireline logs.
4. Notify District office 48 hours prior to old well workover or re-entry.
5. Prior to plugging, prepare a plugging plan, then obtain agreement from the appropriate district office for an approved plugging plan.
6. Submit plugging report (CP-4) to K.C.C. after plugging is completed.
7. Obtain an approved injection docket number before disposing of salt water.
8. Notify K.C.C. within 10 days when injection commences or terminates.
9. If an alternate 2 completion, cement in the production pipe from below any usable water to surface within 120 days of spud date.

State Corporation Commission of Kansas  
Conservation Division  
200 Colorado Derby Building  
Wichita, Kansas 67202  
(316) 263-3238