

STATE CORPORATION COMMISSION
CONSERVATION DIVISION AGENT REPORT

API Number 15-151-20, 9#5-00.00

200 Colorado Derby Building
Wichita, KS 67202

Operator's Full Name J. A. Allison

Complete Address 300 W. Douglas Ste. 305 Wichita 67202

Lease Name Jurnal Well No. 2

Location SE-NE-SW Sec. 17 Twp. 26 Rge. 11 (East) (West)

County Pratt Total Depth 4475'

Abandoned Oil Well Gas Well Input Well SWD Well D&A

Other well as hereinafter indicated _____

Plugging Contractor Kelso Casing Pulling

Address Chase, Kansas License No. 183

Operation Completed: Hour: 10⁴⁵ AM Day: 16 Month: 6 Year: 1982

Plugging Operations attended by Agent?: All Part None

The above well was plugged as follows:

5 1/2" set @ 4005' w/125 #
PB to 4000' Top Refr 3938' - 3942'
SB to 3900' 45 #
15 gal 6 shells 10 gal Release Plug
& displace w/ 150 # common 390 c.c.
SEP 300 #
Allied

Amount of Surface Casing: 263' of 8 5/8" sp w/225 #

I hereby certify that the above plugging instructions were given as herein stated.

Signed: [Signature]
Conservation Division Agent

I hereby state that I was not present while the above well was being plugged, however, to the best of my knowledge and belief it was plugged as herein stated. A full account for my not being present is as follows:


STATE RECEIVED
JUN 23 1982
CONSERVATION DIVISION
Wichita, Kansas

Signed: _____
Conservation Division Agent

INVOICED
DATE 6-24-82
INV. NO. 494-W

STATE CORPORATION COMMISSION
 CONSERVATION DIVISION
 P. O. Box 17027
 3830 S. Meridian
 Wichita, Kansas 67217

Township 26s Range 11w County Pratt Pool _____

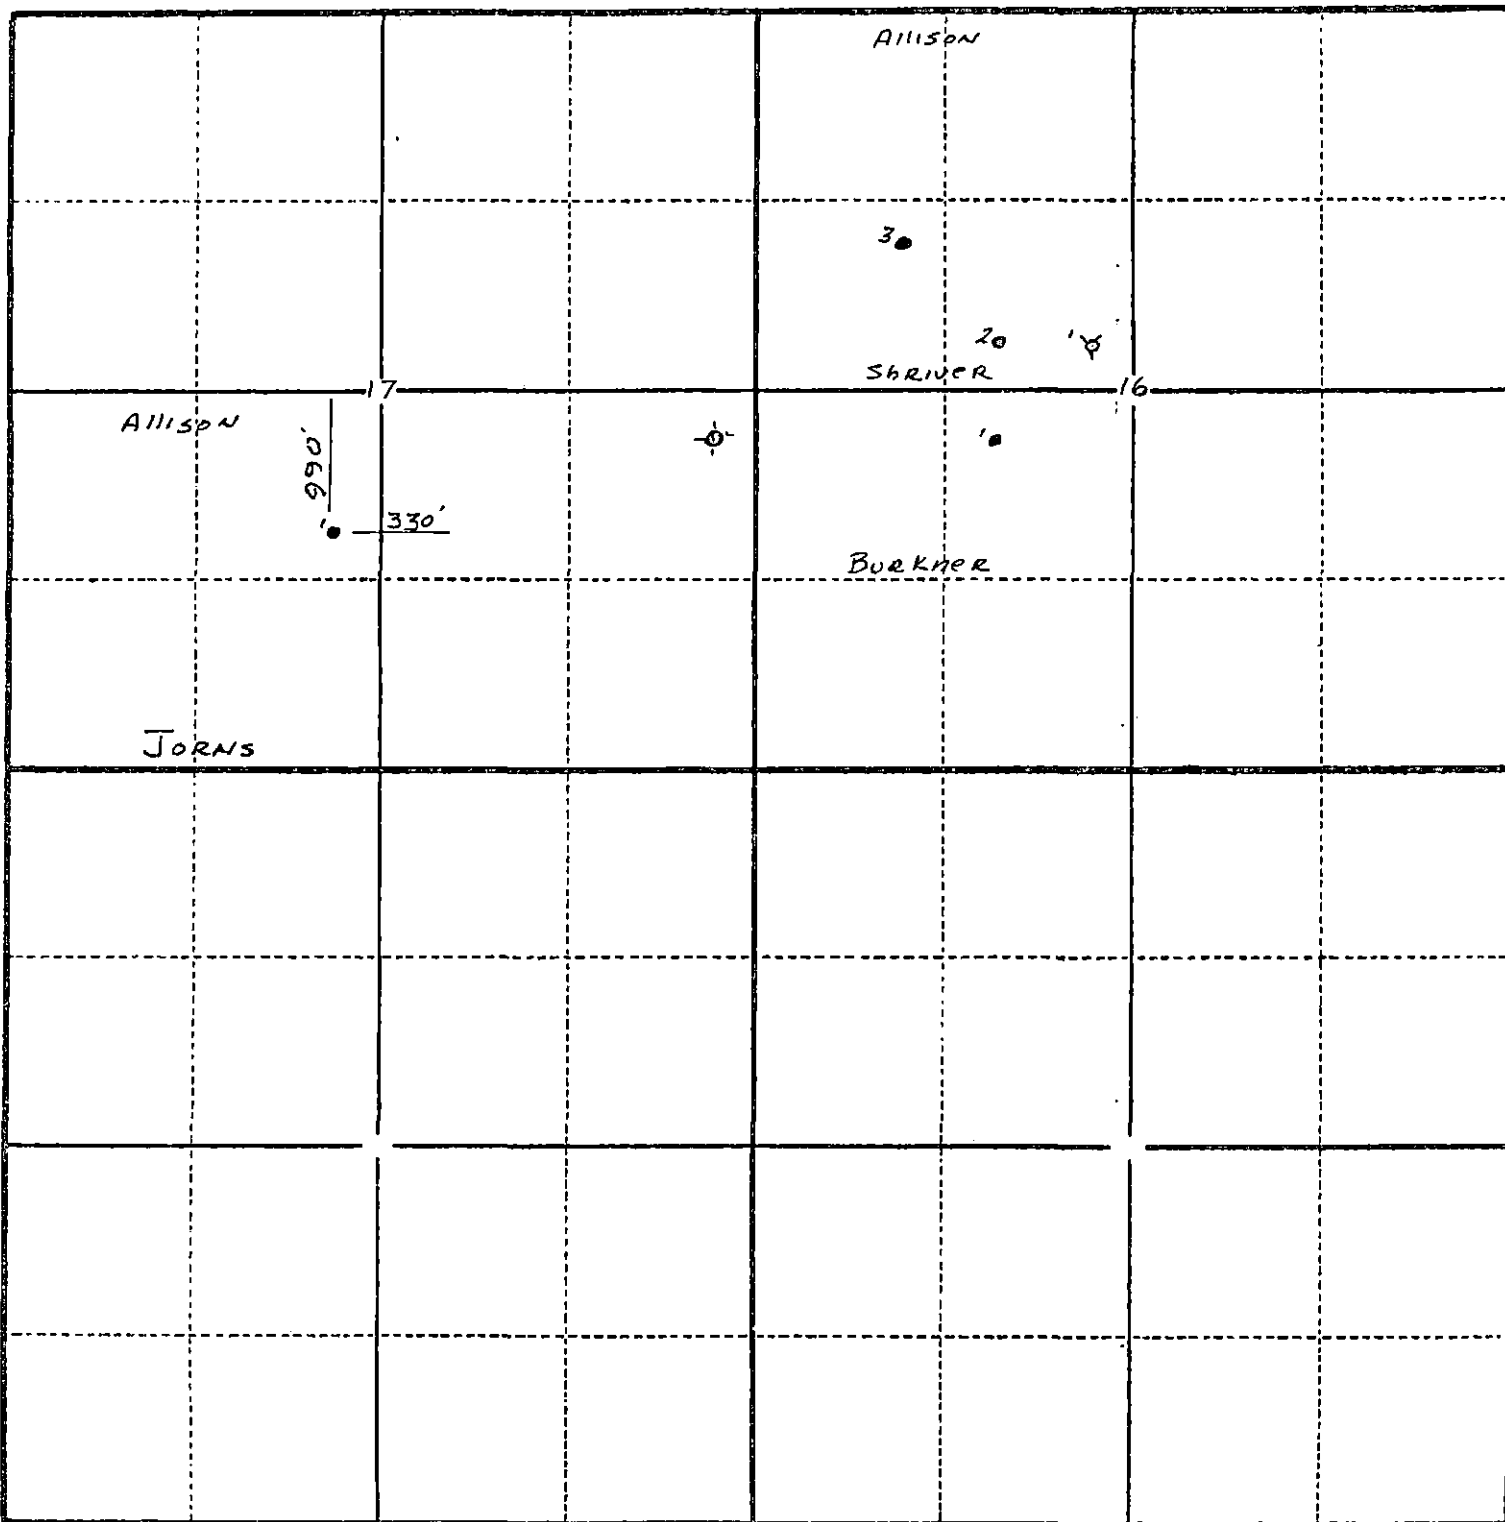

STATE OF KANSAS,
 COUNTY OF SEDGWICK

I, J. A. ALLISON

of 300 West Douglas, Suite 305, Wichita, Kansas 67202, do hereby certify that the above locations, feet measurements and areas are true and correct to the best of my knowledge.

RECEIVED
 STATE CORPORATION COMMISSION

J. A. ALLISON

Subscribed and sworn to before me this 27th day of July, 1981

SEP - 4 1981

My commission expires January 14, 1982

Frances O. Erhard
 CONSERVATION DIVISION
 Wichita, Kansas
 NOTARY PUBLIC

FRANCES O. ERHARD

