

This form shall be filed in duplicate with the Kansas Corporation Commission, 200 Colorado Derby Building, Wichita, Kansas 67202, within ten days after the completion of the well, regardless of how the well was completed.

Attach separate letter of request if the information is to be held confidential. If confidential, only file one copy. Information on side one will be of public record and side two will then be held confidential.

Circle one: Oil, Gas, (Dry), SWD, OWWO, Injection. Type and complete ALL sections. Applications must be filed for dual completion, commingling, SWD and injection, T.A.

Attach wireline logs (i.e. electrical log, sonic log, gamma ray neutron log, etc.). KCC # (316) 263-3238. (Rules 82-2-105 & 82-2-125)

OPERATOR Raymond Oil Company, Inc.

API NO. 15-151-21, 120-00-00

ADDRESS One Main Place, Suite 900

COUNTY Pratt

Wichita, Kansas 67202

FIELD Grizzell

**CONTACT PERSON Kathleen Pipes

PROD. FORMATION --

PHONE 316/267-4214

LEASE Southwestern College

PURCHASER --

WELL NO. 1-B

ADDRESS --

WELL LOCATION SE NE SE

DRILLING Murfin Drilling Company

990 Ft. from N Line and

CONTRACTOR

330 Ft. from E Line of

ADDRESS 617 Union Center

the SE/4 SEC. 4 TWP. 26S RGE. 15W

Wichita, Kansas 67202


WELL PLAT

PLUGGING Murfin Drilling Company

CONTRACTOR

ADDRESS 617 Union Center

Wichita, Kansas 67202

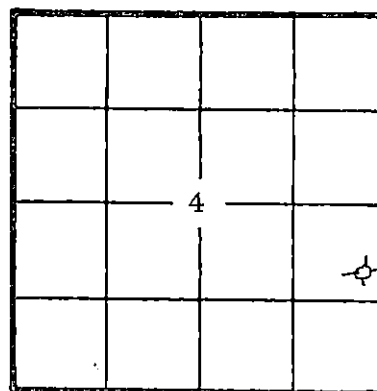

KCC [check]
KGS [check]
(Office Use)

TOTAL DEPTH 3950 PBD

SPUD DATE 3-20-82 DATE COMPLETED 3-27-82

ELEV: GR 2036' DF KB 2045'

DRILLED WITH (CABLE) (ROTARY) (AIR) TOOLS

Amount of surface pipe set and cemented 329' w/300 sx DV Tool Used?

A F F I D A V I T

STATE OF KANSAS, COUNTY OF SEDGWICK SS, I,

Pat R. Raymond OF LAWFUL AGE, BEING FIRST DULY SWORN UPON HIS OATH,

DEPOSES THAT HE IS Vice-President (FOR)(OF) Raymond Oil Company, Inc.

OPERATOR OF THE Southwestern College LEASE, AND IS DULY AUTHORIZED TO MAKE

THIS AFFIDAVIT FOR AND ON THE BEHALF OF SAID OPERATOR, THAT WELL NO. 1-B ON

SAID LEASE HAS BEEN COMPLETED AS OF THE 27th DAY OF March, 19 82, AND THAT

ALL INFORMATION ENTERED HEREIN WITH RESPECT TO SAID WELL IS TRUE AND CORRECT.

FURTHER AFFIANT SAITH NOT.

SUBSCRIBED AND SWORN BEFORE ME THIS 29th DAY OF March, 19 82

(S) Pat R. Raymond - Vice-President
March 19 82

MY COMMISSION EXPIRES: March 22, 1983

NOTARY PUBLIC
Kathleen Pipes

RECEIVED
STATE CORPORATION COMMISSION

**The person who can be reached by phone regarding any questions concerning this information. Within 45 days of completion, a witnessed initial test by the Commission is required if the well produces more than 25 BOPD or is located in a Basic Order Pool.

APR 5 1982
WICHITA DIVISION
Wichita Kansas

SIDE TWO

WELL LOG

Show all important zones of porosity and contents thereof; cored intervals, and all drill-stem tests, including depth interval tested, cushion used, time tool open, flowing and shut-in pressures, and recoveries.

SHOW GEOLOGICAL MARKERS, LOGS RUN, OR OTHER DESCRIPTIVE INFORMATION.

FORMATION DESCRIPTION, CONTENTS, ETC.	TOP	BOTTOM	NAME	DEPTH
No Drill Stem Tests				LOG TOPS
			Admire	2944
			Tarkio	3145
			Howard	3301
			Topeka	3407
			Oread	3609
			Heebner	3729
			Brown Lm	3881
			Lansing	3899
			LTD	3949
Plugged 3-27-82				

Report of all strings set— surface, intermediate, production, etc. CASING RECORD (New) or (Used)

Purpose of string	Size hole drilled	Size casing set (in O.D.)	Weight lbs/ft.	Setting depth	Type cement	Sacks	Type and percent additives
Surface	12-1/4	8-5/8	20#	329'	Common	300	2% gel - 3% cc

LINER RECORD

PERFORATION RECORD

Top, ft.	Bottom, ft.	Sacks cement	Shots per ft.	Size & type	Depth interval

TUBING RECORD

Size	Setting depth	Packer set at

ACID, FRACTURE, SHOT, CEMENT SQUEEZE RECORD

Amount and kind of material used	Depth interval treated

Date of first production D & A	Producing method (flowing, pumping, gas lift, etc.)	Gravity
-----------------------------------	-----------------------------------------------------	---------

RATE OF PRODUCTION PER 24 HOURS	Oil bbls.	Gas MCF	Water %	Gas-oil ratio bbls.	CFPB
---------------------------------	--------------	------------	------------	------------------------	------

Disposition of gas (vented, used on lease or sold)

Perforations