

NEW ACO-1 FORM

SIDE ONE

STATE CORPORATION COMMISSION OF KANSAS OIL & GAS CONSERVATION DIVISION WELL COMPLETION OR RECOMPLETION FORM ACO-1 WELL HISTORY

DESCRIPTION OF WELL AND LEASE

Operator: license # 9232 name Timberline Oil & Gas Corp. address 105 E. 8th City/State/Zip Pratt, KS 67124

Operator Contact Person Brant Grote Phone (316) 672-9476

Contractor: license # 5138 name Cougar Drilling Co., Inc.

Wellsite Geologist Brant C. Grote Phone (316) 672-9476

PURCHASER Permian

Designate Type of Completion X New Well Re-Entry Workover

X Oil SWD Temp Abd Gas Inj Delayed Comp. Dry Other (Core, Water Supply etc.)

If OWWO: old well info as follows: Operator Well Name Comp. Date Old Total Depth

WELL HISTORY

Drilling Method: X Mud Rotary Air Rotary Cable 5-19-86 5-24-86 5-25-86 Spud Date Date Reached TD Completion Date

4270' KB 4216' K.B. Total Depth PBTD

Amount of Surface Pipe Set and Cemented at 294 KB Cement to surface

Multiple Stage Cementing Collar Used? Yes No

If Yes, Show Depth Set feet

If alternate 2 completion, cement circulated from feet depth to w/ SX cmt

API NO. 15- 151-21,790

County Pratt

C. SW/4 Sec 35 Twp 26 Rge 12

1320 Ft North from Southeast Corner of Section 3960 Ft West from Southeast Corner of Section


Lease Name G. Studer Well# 5

Field Name Stead South

Producing Formation Mississippi

Elevation: Ground 1873 KB 1883

Section Plat

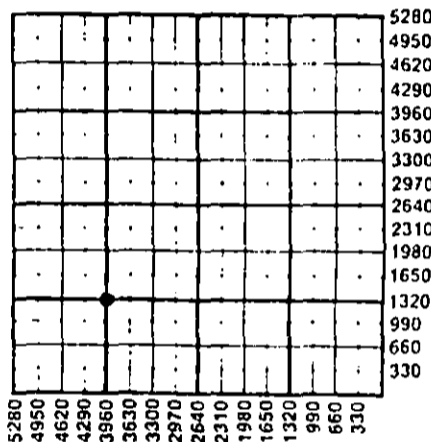

WATER SUPPLY INFORMATION

Source of Water: Division of Water Resources Permit # T 86-218

X Groundwater 2310 Ft North From Southeast Corner and (Well) 4290 Ft West From Southeast Corner of Sec 35 Twp 26S Rge 12 East West

Surface Water Ft North From Southeast Corner and (Stream, Pond etc.) Ft West From Southeast Corner Sec Twp Rge East West

Other (explain) (purchased from city, R.W.D.#)

Disposition of Produced Water: Disposal Repressuring

Docket #

INSTRUCTIONS: This form shall be completed in duplicate and filed with the Kansas Corporation Commission, 200 Colorado Derby Building, Wichita, Kansas 67202, within 90 days after completion or recompletion of any well.

Information on side two of this form will be held confidential for a period of 12 months if requested in writing and submitted with the form.

One copy of all wireline logs and drillers time log shall be attached with this form. Submit CP-4 form with all plugged wells. Submit CP-111 form with all temporarily abandoned wells.

All requirements of the statutes, rules, and regulations promulgated to regulate the oil and gas industry have been fully complied with and the statements herein are complete and correct to the best of my knowledge.

Signature Brant Grote Title President

RECEIVED STATE CORPORATION COMMISSION JUN 02 1986 CONSERVATION DIVISION WICHITA, KANSAS Date 6/16/86

Subscribed and sworn to before me this 6th day of June 19 86

Notary Public Janice M. McCune Date Commission Expires 10/18/89

JANICE M. McCUNE NOTARY PUBLIC STATE OF KANSAS MY APPT. EXPIRES 10-18-89

K.C.C. OFFICE USE ONLY Letter of Confidentiality Attached Wireline Log Received Drillers Timelog Received Distribution KCC KGS SWD/Rep Plug NGPA Other

McCune, 35 Imp. Res. Reg. 12/21/86