

TYPE

AFFIDAVIT OF COMPLETION FORM

ACO-1 WELL HISTORY

Compt. _____

SIDE ONE

Two (2) copies of this form shall be filed with the Kansas Corporation Commission, 200 Colorado Derby Building, Wichita, Kansas 67202, within thirty (30) days after the completion of a well, regardless of how the well was completed.

Attach separate letter of request if the information is to be held confidential. If confidential, only file one copy. Information on Side One will be of public record and Side Two will then be held confidential.

Applications must be made on dual completion, commingling, salt water disposal, injection and temporarily abandoned wells.

C Attach one copy only wireline logs (i.e. electrical log, sonic log, gamma ray neutron log, etc.). (Rules 82-2-105 & 82-2-125) KCC# (316) 263-3238.

LICENSE # 5047 EXPIRATION DATE _____

OPERATOR Rupe Oil Company, Inc. API NO. 15-151-21,251-00-00

ADDRESS P. O. Box 2273 COUNTY Pratt

Wichita, Kansas 67201 FIELD _____

** CONTACT PERSON W. G. Clement PROD. FORMATION _____

PHONE 316/262-3748

PURCHASER _____ LEASE Dietz

ADDRESS _____ WELL NO. 1

WELL LOCATION SW NW

DRILLING Landmark Drilling Corp. 660 Ft. from W. Line and

CONTRACTOR ADDRESS P. O. Box 18595 660 Ft. from S. Line of

Wichita, Kansas 67218 the NW (Qtr.) SEC 5 TWP 27SRGE 11 (E)

Wichita, Kansas 67218 the NW (Qtr.) SEC 5 TWP 27SRGE 11 (W)

PLUGGING Halliburton Services WELL PLAT (Office Use Only)

CONTRACTOR P. O. Box 963

ADDRESS Pratt, Kansas 67124


TOTAL DEPTH 4090' PBDT _____

SPUD DATE 2/10/83 DATE COMPLETED 2/23/83

ELEV: GR 1818' DF _____ KB 1823'

DRILLED WITH (CABLE) (ROTARY) (AIR) TOOLS.

DOCKET NO. OF DISPOSAL OR REPRESSURING WELL BEING USED TO DISPOSE OF WATER FROM THIS LEASE _____

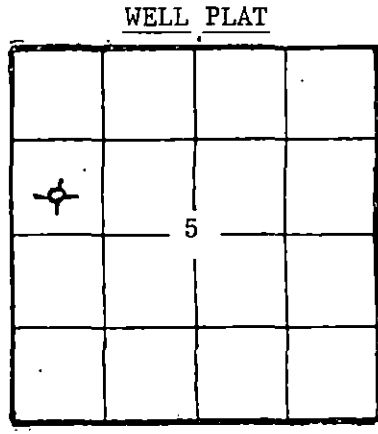

(Office Use Only) KCC KGS SWD/REP _____ PLG. _____

Amount of surface pipe set and cemented 300 DV Tool Used? No

THIS AFFIDAVIT APPLIES TO: (Circle ONE) - Oil, Gas, Shut-in Gas, (Dry) Disposal, Injection, Temporarily Abandoned, OWWO. Other _____

ALL REQUIREMENTS OF THE STATUTES, RULES AND REGULATIONS PROMULGATED TO REGULATE THE OIL AND GAS INDUSTRY HAVE BEEN FULLY COMPLIED WITH.

MAR 1 1983

A F F I D A V I T

CONSERVATION DIVISION Wichita, Kansas

W. G. Clement, being of lawful age, hereby certifies

that: I am the Affiant, and I am familiar with the contents of the foregoing Affidavit. The statements and allegations contained therein are true and correct.

W. G. Clement (Name) W. G. Clement

SUBSCRIBED AND SWORN TO BEFORE ME this 11th day of March, 1983.

Faye W. Leach (NOTARY PUBLIC) Faye W. Leach

MY COMMISSION EXPIRES: September 30, 1985

** The person who can be reached by phone regarding any questions concerning this information.