


STATE OF KANSAS
STATE CORPORATION COMMISSION

WELL PLUGGING RECORD

Give All Information Completely
Make Required Affidavit
Mail or Deliver Report to
Conservation Division
State Corporation Comm.
245 North Water
Wichita, KS 67202

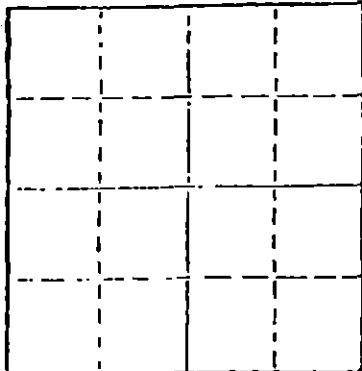

Locate well correctly on above
Section Plat

PRATT County, Sec. 12 Twp. 26 Rge. 14 ~~E~~/W
Location as "NE/CNW $\frac{1}{4}$ SW $\frac{1}{4}$ " or footage from lines
C E/2 E/2 NE/4

Lease Owner L. D. Davis
Lease Name Gee Well No. 1
Office Address R. R. 1 Box 183 B Great Bend, Kans.
Character of Well (Completed as Oil, Gas or Dry Hole)
Dry Hole

Date Well completed June 28, 1982
Application for plugging filed June 28 19 82
Application for plugging approved June 28 19 82
Plugging commenced 1:30 P. M. June 28 19 82
Plugging completed 2:30 P. M. June 28 19 82
Reason for abandonment of well or producing formation

If a producing well is abandoned, date of last production 19

Was permission obtained from the Conservation Division or
its agents before plugging was commenced? yes

Name of Conservation Agent who supervised plugging of this well Morise Leslie = Nashville
Producing formation Depth to top Bottom Total Depth of Well 4450
Show depth and thickness of all water, oil and gas formations.

OIL, GAS OR WATER RECORDS

CASING RECORD

FORMATION	CONTENT	FROM	TO	SIZE	PUT IN	PULLED OUT

Describe in detail the manner in which the well was plugged, indicating where the mud fluid
was placed and the method or methods used in introducing it into the hold. If cement or other
plugs were used, state the character of same and depth placed, from feet to
feet for each plug set.

60 sx. 50/50 Pozmix, at 700'
40 sx. " " " " 300'
10 sx. " " " " 40'
10 sx. in rathole
Plugging on location


(If additional description is necessary, use BACK of this sheet)

Name of Plugging Contractor L. D. Drilling, Inc.

STATE OF KANSAS COUNTY OF BARTON, ss.
L. D. Davis (employee of owner) or (owner)
of the above-described well, being first duly sworn on oath, says: That I have knowledge of
the facts, statements, and matters herein contained and the log of the above-described well
as filed and that the same are true and correct. So help me God.

(Signature) L. D. Davis
L. D. Davis Great Bend, Kans. 67530
(Address)

SUBSCRIBED AND SWORN TO before me this 30th day of June, 19 82

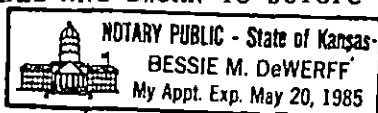

Bessie M. DeWerff
Bessie M. DeWerff Notary Public.

My commission expires 5-20-85