

STATE OF KANSAS
STATE CORPORATION COMMISSION


Give All Information Completely
Make Required Affidavit
Mail or Deliver Report to:
Conservation Division
State Corporation Commission
211 No. Broadway
Wichita, Kansas

WELL PLUGGING RECORD

Pratt County, Sec. 20 Twp. 26 Rge. 14 (E) W (W)

Location as "NE/CNW/SW" or footage from lines NE NE SW
Lease Owner Mull Drilling Co Inc.
Lease Name Schoonover Well No. 1
Office Address 670 N. 14th. Natl. Bank Bldg. Wichita, Kansas
Character of Well (completed as Oil, Gas or Dry Hole) Dry Hole
Date well completed 7-4 1960
Application for plugging filed 7-4 1960
Application for plugging approved 7-4 1960
Plugging commenced 11:00 A.M. 7-4 1960
Plugging completed 2:00 P.M. 7-4 1960
Reason for abandonment of well or producing formation No Production

NORTH

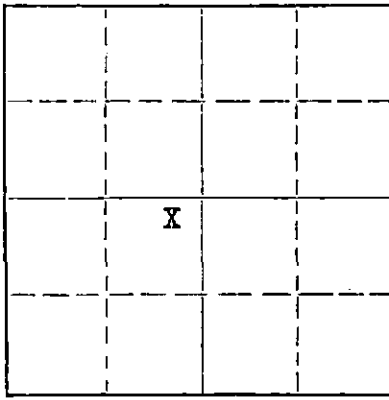

Locate well correctly on above
Section Plat

If a producing well is abandoned, date of last production _____ 19____
Was permission obtained from the Conservation Division or its agents before plugging was commenced? Yes

Name of Conservation Agent who supervised plugging of this well Frank Broadfoot
Producing formation _____ Depth to top _____ Bottom _____ Total Depth of Well _____ Feet
Show depth and thickness of all water, oil and gas formations.

OIL, GAS OR WATER RECORDS

CASING RECORD

FORMATION	CONTENT	FROM	TO	SIZE	PUT IN	PULLED OUT

Describe in detail the manner in which the well was plugged, indicating where the mud fluid was placed and the method or methods used in introducing it into the hole. If cement or other plugs were used, state the character of same and depth placed, from _____ feet to _____ feet for each plug set.

Hole filled to within 240 ft. of top of hole, plug pushed to this depth with drill pipe 1/2 sack hulls put on top of plug, and 20 sacks cement put on top of plug through drill pipe. Hole filled with drilling mud to within 30 ft. of top of hole and plug pushed to this depth. 1/2 sack hulls put on top of plug and 10 sacks cement put on top of hulls. This filled hole to top completing plugging of hole. Two sacks put in rat hole plugging same.

RECEIVED
STATE CORPORATION COMMISSION

JUL 12 1960

CONSERVATION DIVISION
Wichita, Kansas

(If additional description is necessary, use BACK of this sheet)

Name of Plugging Contractor Co. Tools
Address Same as above.

STATE OF KANSAS COUNTY OF SEDGWICK, ss.

Joseph O. Butts (employee of owner) or owner or operator of the above-described well, being first duly sworn on oath, says: That I have knowledge of the facts, statements, and matters herein contained and the log of the above-described well as filed and that the same are true and correct. So help me God.

(Signature) Joseph O. Butts
(Address) _____

SUBSCRIBED AND SWORN TO before me this 9th day of July, 1960

My commission expires January 28, 1961.

Ethel Zimmerman
Ethel Zimmerman
Notary Public.



ROTARY DRILLERS LOG

COMPANY: Mull Drilling Co., Inc. Et Al
Wichita, Kansas

ROTARY DRILLING COMMENCED: 6/23/60

CONTRACTORS: Mull Drilling Co., Inc.
Wichita, Kansas

ROTARY DRILLING COMPLETED: 7/5/60

CASING RECORD: 945' of 8 5/8" casg.
cmt. w/550 sax cmt.
D & A

LOCATION: SCHOONOVER #1
NE4 NE4 SW/4 20-26S-14W
Pratt County, Kansas

(Figures indicate bottom of formation - measurements from top of Rotary Bushing.)

1225'	Red Bed
1900'	Shale & Shells
3045'	Lime & Shale
3726'	Sandy Lime & Shale
4026'	Lime & Shale
4055'	Lime
4240'	Lime w/Shale
4291'	Lime
4327'	Lime w/Shale
4345'	Lime w/chert
4378'	Mississippi Chert
4406'	Kinderhook Shale, etc.
4426'	Lime
4499'	Viola
4576'	Simpson
4595'	Arbuckle - total depth

RECEIVED
STATE CORPORATION COMMISSION

OCT. 11 1960

CONSERVATION DIVISION
Wichita, Kansas

I hereby certify that this is a true and correct copy of the above log to the best of my knowledge.

MULL DRILLING COMPANY, INC.

Robert L. Reinke

Robert Reinke, Geologist

STATE OF KANSAS)
) SS
COUNTY OF SEDGWICK)

Subscribed and sworn to before me this 11th day of July, 1960.



Mudge W. Miller
Notary Public

My Commission Expires: February 24, 1964