


STATE OF KANSAS
STATE CORPORATION COMMISSION

WELL PLUGGING RECORD

Give All Information Completely
Make Required Affidavit
Mail or Deliver Report to:
Conservation Division
State Corporation Commission
800 Biting Building
Wichita, Kansas

Pratt County, Sec. 24 Twp. 26 Rge. 14 (E) (W)
Location as "NE/CNW/SW" or footage from lines NW SE NE
Lease Owner John W. McKnab
Lease Name Annie E. Bennett Well No. 1
Office Address 923 Union National Bank Building
Character of Well (completed as Oil, Gas or Dry Hole) Dry Hole
Date well completed March 31, 1955 19
Application for plugging filed March 31, 1955 19
Application for plugging approved March 31, 1955 19
Plugging commenced March 31, 1955 19
Plugging completed March 31, 1955 19
Reason for abandonment of well or producing formation Dry Hole

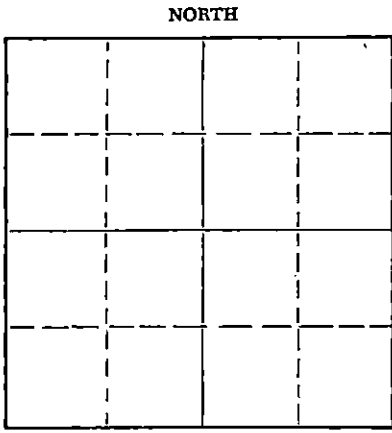

Locate well correctly on above
Section Plat

If a producing well is abandoned, date of last production _____ 19
Was permission obtained from the Conservation Division or its agents before plugging was commenced? Yes

Name of Conservation Agent who supervised plugging of this well M. A. Rives
Producing formation _____ Depth to top _____ Bottom _____ Total Depth of Well 1546 Feet
Show depth and thickness of all water, oil and gas formations.

OIL, GAS OR WATER RECORDS

CASING RECORD

FORMATION	CONTENT	FROM	TO	SIZE	PUT IN	PULLED OUT
Anhydrite		0	882'	8 5/8"	Mar 13, 1955	

Describe in detail the manner in which the well was plugged, indicating where the mud fluid was placed and the method or methods used in introducing it into the hole. If cement or other plugs were used, state the character of same and depth placed, from _____ feet to _____ feet for each plug set.

Gunned Pitw to raise weight on mud - circulate till got returns back - layed down drill pipe - filled hole to 300 feet with mud - Set top plug with hulls at that depth - Cement with 20 sacks of cement through ten joints of drill pipe - filled hole to 35 feet with mud - set Howco top plug with hulls at that depth - cemented with 10 sacks of cement - Tied top plug with steel wire.

RECEIVED
STATE CORPORATION COMMISSION
APR 21 1955

(If additional description is necessary, use BACK of this sheet)

Name of Plugging Contractor _____
Address _____

STATE OF KANSAS COUNTY OF SEDGWICK ss.
Don Gardner (employee of owner) or (owner of owner) of the above-described well, being first duly sworn on oath, says: That I have knowledge of the facts, statements, and matters herein contained and the log of the above-described well as filed and that the same are true and correct. So help me God.

(Signature) [Signature]
923 Union National Bank Building
(Address)

SUBSCRIBED AND SWORN to before me this 6th day of April, 1955

My commission expires November 21, 1956

[Signature]
Notary Public.

PLUGGING
PLK SEC 24 T 26 R 14W
BOOK PAGE 68 LINE 32

