


STATE OF KANSAS
STATE CORPORATION COMMISSION

Give All Information Completely
Make Required Affidavit
Mail or Deliver Report to:
Conservation Division
State Corporation Commission
800 Bittling Building
Wichita, Kansas

WELL PLUGGING RECORD

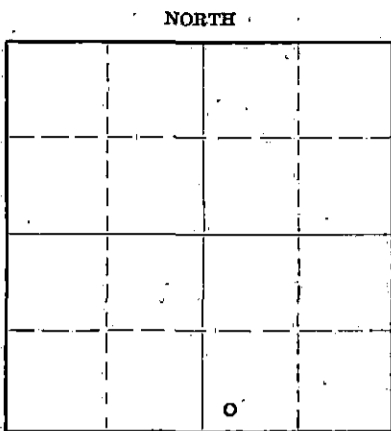

Pratt County, Sec. 26 Twp. 26 S. Rge. 14 (W) SW SW SE
Location as "NE/CNW 1/4 SW 1/4" or footage from lines
Lease Owner Twin Drilling, Inc.
Lease Name Dodson Well No. 1
Office Address 1005 Central Building, Wichita, Kansas
Character of Well (completed as Oil, Gas or Dry Hole) Dry Hole
Date well completed March 7 19 58
Application for plugging filed March 7 19 58
Application for plugging approved March 12 19 58
Plugging commenced March 7 19 58
Plugging completed March 7 19 58
Reason for abandonment of well or producing formation Dry Hole
If a producing well is abandoned, date of last production None 19
Was permission obtained from the Conservation Division or its agents before plugging was commenced? Yes

Name of Conservation Agent who supervised plugging of this well Frank Broadfoot, 222 S. Main, St. John, Kansas
Producing formation Depth to top Bottom Total Depth of Well 4600' Feet
Show depth and thickness of all water, oil and gas formations.

OIL, GAS OR WATER RECORDS

CASING RECORD

Formation	Content	From	To	Size	Put In	Pulled Out
				8 5/8"	335'	

Describe in detail the manner in which the well was plugged, indicating where the mud fluid was placed and the method or methods used in introducing it into the hole. If cement or other plugs were used, state the character of same and depth placed, from feet to feet for each plug set.

Pushed plug to 300'. Cemented through drill pipe with 20 sacks of mixed cement. Filled hole on up with rotary mud to 30' of base of cellar. Set plug and cemented with 10 sacks of cement.

RECEIVED
STATE CORPORATION COMMISSION
MAR 14 1958
CONSERVATION DIVISION
Wichita, Kansas

(If additional description is necessary, use BACK of this sheet)

Correspondence regarding this well should be addressed to Twin Drilling, Inc.
Address 1005 Central Building
Wichita, Kansas

STATE OF Kansas, COUNTY OF Sedgwick, ss.
C. R. Dunne (employee-of-owner) or (owner or operator) of the above-described well,
being first duly sworn on oath, says: That I have knowledge of the facts, statements, and matters herein contained and the log of the above-described well as filed and that the same are true and correct. So help me God.

(Signature) *C. R. Dunne*
1005 Central Building, Wichita, Kansas
(Address)

SUBSCRIBED AND SWORN to before me this 13 day of March 19 58

Alameda Ray
Notary Public.

My commission expires September 9, 1961

PLUGGING
FILE SEC 26 T 26 R 14 W
BOOK PAGE 88 LINE 30

WELL LOG

Well: Dodson #1 Commenced: February 24, 1958
Completed: March 7, 1958
Location: SW SW SE Elevation: 1972 DF
Sec. 26-26S-14W 1970 GR
Pratt County, Kansas
Operator: Twin Drilling, Inc. Contractor: Same
1005 Central Building
Wichita, Kansas

Casing Record

8 5/8" 335' w/225 Sacks

Sand & Clay	200	Shale & Chert	4411
Shale & Shells	335	Lime	4475
Shale	375	(Simpson 4474)	
Shale & Sand	860	Shale & Sand	4510
Anhydrite	880	Shale & Sandy Shale	4556
Shale & Lime Shells	1320	Lime	4600 R.T.D.
Shale & Shells	1600		
Lime & Shale	2035		
Lime w/Shale Breaks	2350	Dry Hole	
Lime & Shale	2775		
Lime	2870		
Shale & Lime	3085		
Shale w/Lime Streaks	3255		
Lime & Shale	3333		
Lime	3405		
Lime w/Shale Streaks	3565		
Lime & Shale	3893		
(Heebner 3658)			
(Br. Lime 3826)			
(Lansing 3855)			
Lime	4175		
(Base K.C. 4172)			
Lime & Shale	4290		
Lime	4320		
(Mississippi 4302)			
Chert	4342		
Shale	4348		
Chert	4380		
(Kinderhook 4379)			

STATE OF KANSAS)
) ss.
COUNTY OF SEDGWICK)

The undersigned, TWIN DRILLING, INC., hereby certifies that the above log is a true and correct log of the formations encountered in drilling the above well as reflected by the Daily Drilling Report.

TWIN DRILLING, INC.

By Alameda Day
Secretary

Subscribed and sworn to before me
this 13th day of March, 1958.

James S. Glick
Notary Public

commission expires
September 29, 1960.

PLUGGING
FILED SEP 26 1958
BOOK PAGE 88 LINE 30