


WELL PLUGGING RECORD

Give All Information Completely
Make Required Affidavit
Mail or Deliver Report to:
Conservation Division
State Corporation Commission
800 Bittling Building
Wichita, Kansas

Pratt County, Sec. 1 Twp. 26 Rge. (E) 11 (W)

Location as "NE/CNW%SW%" or footage from lines SW SW NE
Lease Owner Deep Rock Oil Corporation
Lease Name SLATER Well No. 1
Office Address Petroleum Building, Wichita, Kansas.
Character of Well (completed as Oil, Gas or Dry Hole) Dry Hole
Date well completed August 8, 1954
Application for plugging filed verbally August 8, 1954
Application for plugging approved verbally August 8, 1954
Plugging commenced August 8, 1954
Plugging completed August 8, 1954
Reason for abandonment of well or producing formation Dry hole

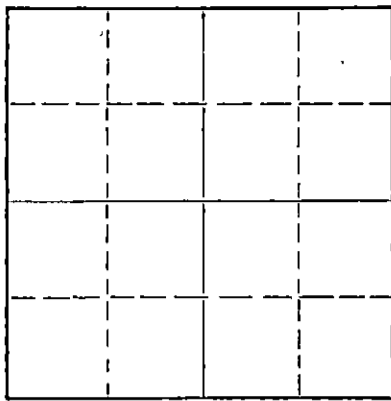

Locate well correctly on above Section Plat

If a producing well is abandoned, date of last production 19
Was permission obtained from the Conservation Division or its agents before plugging was commenced? verbally - yes

Name of Conservation Agent who supervised plugging of this well
Producing formation Depth to top Bottom Total Depth of Well 4450 Feet
Show depth and thickness of all water, oil and gas formations.

OIL, GAS OR WATER RECORDS

CASING RECORD

FORMATION	CONTENT	FROM	TO	SIZE	PUT IN	PULLED OUT
				10-3/4"	289'	

Describe in detail the manner in which the well was plugged, indicating where the mud fluid was placed and the method or methods used in introducing it into the hole. If cement or other plugs were used, state the character of same and depth placed, from feet to feet for each plug set.

Filled hole with mud & hulls to 280'
Set 1st plug at 280' with 25 sacks cement
Filled hole with mud to 30'
Set 2nd plug at 30' with 130 sx hulls & 15 sx cement.

(If additional description is necessary, use BACK of this sheet)

Name of Plugging Contractor Musgrove Petroleum Corporation
Address 518 Petroleum Building, Wichita, Kansas.

STATE OF Kansas COUNTY OF Sedgwick
I, WAYNE R. DAVY, (employee of owner) or (owner or operator) of the above-described well, being first duly sworn on oath, says: That I have knowledge of the facts, statements, and matters herein contained and the log of the above-described well as filed and that the same are true and correct. So help me God.

(Signature) Wayne R Davy
518 Petroleum Building, Wichita, Kansas.
(Address)

SUBSCRIBED AND SWORN TO before me this 11th day of August 1954
Notary Public.

commission expires July 16, 1954

RECEIVED
STATE CORPORATION COMMISSION
AUG 12 1954
CONSERVATION DIVISION
Wichita, Kansas

PLUGGING
FILE SEC 1 T 26 R 11 W
BOOK PAGE 53 LINE 33

CONTRACTOR'S WELL LOG

COMPANY:	Deep Rock Oil Corporation
CONTRACTOR:	Musgrove Petroleum Corporation
FARM:	SLATER #1
LOCATION:	SW SW NE, Sec. 1-26-11 Pratt County, Kansas
COMMENCED:	July 24, 1954
COMPLETED:	August 8, 1954

0	135	Surface soil & sand
135	292	Sand, Red bed, shell
292	395	Red bed
395	515	Sand & red bed
515	560	Anhydrite
560	955	Red bed, shale & shells
955	1525	Shale & shells
1525	1800	Shale; lime, shells
1800	3812	Lime & shale
3812	3991	Lime
3991	4078	Lime, chert (Miss.)
4078	4230	Shale & lime
4230	4260	Lime & chert
4260	4286	Lime (Viola)
4286	4312	Lime
4312	4450	Lime, sand, shale
	4450	Rotary Total Depth

Set 10-3/4" surface casing at 289' with 225 sacks of cement, 2% Jel, and 2 C. C.

Dry and Abandoned.

STATE OF KANSAS)
) SS
COUNTY OF SEDGWICK)

I, WAYNE R. DAVY, do hereby certify that the above and foregoing is a true and correct copy of the log of the SLATER #1, SW SW NE, Section 1-26-11, Pratt County, Kansas, as reflected by the files of the Musgrove Petroleum Corporation.

MUSGROVE PETROLEUM CORPORATION

BY Wayne R. Davy
Asst. Secretary-Treasurer

Subscribed and sworn to before me, a Notary Public, in and for Sedgwick County, Kansas, this 11th day of August, 1954.

Armed E. Ross
Notary Public

My commission expires July 16, 1955.

RECEIVED
STATE CORPORATION COMMISSION
CONSERVATION DIVISION
Wichita, Kansas

PLUGGING
FILE SEC LT 26-11W
BOOK PAGE 55 LINE 33