

WELL PLUGGING RECORD

Give All Information Completely  
Make Required Affidavit  
Mail or Deliver Report to:  
Conservation Division  
State Corporation Commission  
211 No. Broadway  
Wichita, Kansas

Pratt County. Sec. 2 Twp. 26S Rge. (E) 11 (W)

Location as "NE/CNW/SW" or footage from lines C SE NE

Lease Owner Rains & Williamson Oil Co.

Lease Name FULKS Well No. 1

Office Address 1425 Wichita Plaza, Wichita 2, Kansas

Character of Well (completed as Oil, Gas or Dry Hole) Dry Hole

Date well completed 6-5-64 19

Application for plugging filed June 5 1964

Application for plugging approved June 5 1964


Plugging commenced June 5 1964

Plugging completed June 5 1964

Reason for abandonment of well or producing formation No oil or gas found in commercial quantities.

If a producing well is abandoned, date of last production -- -- 19

Was permission obtained from the Conservation Division or its agents before plugging was commenced? Yes

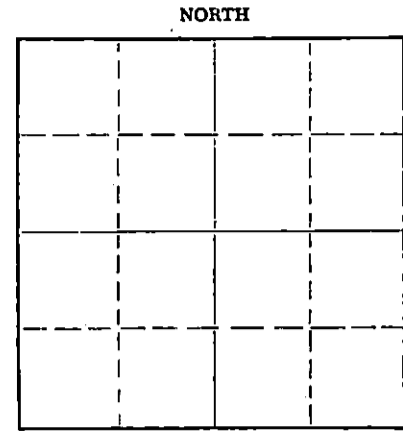

Locate well correctly on above Section Plat

Name of Conservation Agent who supervised plugging of this well Archie Elving, Pratt, Kansas

Producing formation Depth to top Bottom Total Depth of Well 4486 Feet

Show depth and thickness of all water, oil and gas formations.

OIL, GAS OR WATER RECORDS

CASING RECORD

FORMATION	CONTENT	FROM	TO	SIZE	PUT IN	PULLED OUT
				8-5/8"	259'	None

Describe in detail the manner in which the well was plugged, indicating where the mud fluid was placed and the method or methods used in introducing it into the hole. If cement or other plugs were used, state the character of same and depth placed, from feet to feet for each plug set.

Mud back to 250'. Set plug & hulls & cement with 25 sacks cement. Mud back to 40'. Set plug & hulls & capped with 10 sacks cement. 2 sacks of cement in rathole. Plugging completed 6:30 p.m. 6-5-64.

RECEIVED  
STATE CORPORATION COMMISSION

JUN 9 1964

CONSERVATION DIVISION  
Wichita, Kansas

(If additional description is necessary, use BACK of this sheet)

Name of Plugging Contractor Rains & Williamson Oil Co.  
Address 1425 Wichita Plaza, Wichita 2, Kansas

STATE OF KANSAS, COUNTY OF SEDGWICK, ss.  
Wilson Rains

(owner or operator) of the above-described well, being first duly sworn on oath, says: That I have knowledge of the facts, statements, and matters herein contained and the log of the above-described well as filed and that the same are true and correct. So help me God.

(Signature) *Wilson Rains*  
Wilson Rains, Partner  
1425 Wichita Plaza, Wichita, Kansas  
(Address)

SUBSCRIBED AND SWORN TO before me this 8th day of June, 1964.

My commission expires January 8, 1968

*Shirley Keck*  
Shirley Keck Notary Public.

ROTARY DRILLING LOG

Operator: Rains & Williamson Oil Co.  
 #1 FULKS  
 C SE NE Sec. 2-26S-11W  
 Pratt County, Kansas

Contractor: Rains & Williamson  
 Oil Co.  
 Commenced: 5-22-64  
 Completed: 6-5-64  
 Remarks: Set 8-5/8" casing at  
 259' with 170 sacks  
 cement.

Formations

Surface Soil & Clay	20'
Shale	110'
Sand	170'
Shale & Red Bed	700'
Shale	1500'
Lime & Shale	1690'
Lime	2325'
Lime & Shale	2912'
Sand	2949'
Lime	3010'
Lime & Shale	3248'
Lime	4036'
Lime & Chert	4050'
Lime	4111'
Shale	4120'
Shale & Lime	4208'
Shale	4268'
Lime	4348'
Simpson Shale	4359'
Simpson Sand	4374'
Shale	4390'
Shale & Sand	4400'
Sand	4418'
Lime	4429'
Shale	4436'
Arbuckle	4470'
Lime	4486'
RTD	4486'

RECEIVED  
 STATE CORPORATION COMMISSION

JUN 9 1964

CONSERVATION DIVISION  
 Wichita, Kansas

We certify the above log is true and  
 correct to the best of our knowledge  
 and belief.

RAINS & WILLIAMSON OIL CO.

*Wilson Rains*  
 Wilson Rains, Partner

Subscribed and sworn to before me, a Notary Public in and for the State  
 of Kansas, County of Sedgwick, this 8th day of June, 1964.

My Commission Expires: 1-8-68

*Shirley Keck*  
 Shirley Keck, Notary Public