


Give All Information Completely
Make Required Affidavit
Mail or Deliver Report to:
Conservation Division
State Corporation Commission
212 North Market, Insurance Bldg.
Wichita, Kansas

WELL PLUGGING RECORD

NORTH

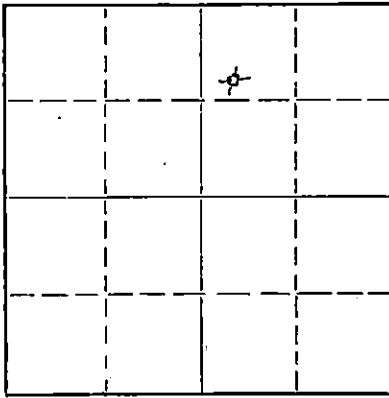

Locate well correctly on above
Section Plat

Pratt County. Sec. 2 Twp. 26S Rge. (E) 11 (W)
Location as "NE/CNW/SW" or footage from lines 4290' from S line & 2310' from East line.
Lease Owner Peel-Hardman Oil Operators
Lease Name Fulks Well No. 1
Office Address R. R. #3, Box 144B, Wichita 20, Kansas
Character of Well (completed as Oil, Gas or Dry Hole) Dry Hole
Date well completed May 10, 19 60
Application for plugging filed May 20, 19 60
Application for plugging approved May 23, 19 60
Plugging commenced May 24, 19 60
Plugging completed May 28, 19 60
Reason for abandonment of well or producing formation Dry Hole

If a producing well is abandoned, date of last production _____ 19____
Was permission obtained from the Conservation Division or its agents before plugging was commenced? Yes

Name of Conservation Agent who supervised plugging of this well Fred Hampel
Producing formation _____ Depth to top _____ Bottom _____ Total Depth of Well 4455 Feet
Show depth and thickness of all water, oil and gas formations.

OIL, GAS OR WATER RECORDS

CASING RECORD

FORMATION	CONTENT	FROM	TO	SIZE	PUT IN	PULLED OUT
		0	258'	8 5/8"	259'	None
		0	3998'	5 1/2"	3998'	3135'

Describe in detail the manner in which the well was plugged, indicating where the mud fluid was placed and the method or methods used in introducing it into the hole. If cement or other plugs were used, state the character of same and depth placed, from _____ feet to _____ feet for each plug set.

Well had been plugged back to 3575'.
From 3575' to 3560' - Sand & four sacks cement with dump bailer.
Pulled pipe from hole and cement trucks pumped 20 sacks mud and 50 sacks cement into hole.
Surface pipe filled with cement to bottom of cellar.

RECEIVED
STATE CORPORATION COMMISSION

JAN 30 1963

CONSERVATION DIVISION
Wichita, Kansas

(If additional description is necessary, use BACK of this sheet)

Name of Plugging Contractor Barnes & Sons Pipe pulling Co.
Address Russell, Kansas

STATE OF KANSAS, COUNTY OF SEDGWICK, ss.
William Herbert (employee of owner) or (~~owner or operator~~) of the above-described well, being first duly sworn on oath, says: That I have knowledge of the facts, statements, and matters herein contained and the log of the above-described well as filed and that the same are true and correct. So help me God.

(Signature) [Signature]
R. R. #3, Box 144B, Wichita 20, Kansas
(Address)

SUBSCRIBED AND SWORN TO before me this 21 day of January, 19 63

My commission expires March 4, 1966
Marian M. Herbert
Marian M. Herbert Notary Public.

RECEIVED
STATE CORPORATION COMMISSION

MAY 23 1960

CONSERVATION DIVISION
Wichita, Kansas

DRILLER'S LOG

Company: Peel-Hardman Oil Operators

Location: 4290' from S. line &
2310' from E. line of
Sec. 2-26S-11W

Farm: Fulks No. 1

Total Depth: 4455'

County: Pratt,
Kansas

Comm.: 4-10-60 Comp.: 4-26-60
Contractor: Glenn W. Peel Drilling Co.

Production:

Casing: 8 5/8" @ 238' cem.
5 1/2" @ 3998' cem.

Figures below indicate bottom of formations

Surface Clay & Sand	0 -	60'
Sand		90
Shale		115
Sand		180
Sand & Shale		215
Red Bed		505
Anhydrite		540
Red Bed		590
Shale & Shells		1475
Lime		2200
Lime w/Shale streaks		2335
Lime & Shale		3165
Lime		3270
Lime & Shale		3575
Lime		3596
Shale & Lime		3645
Lime		4030
Mississippi Lime		4078
Lime		4130
Shale & Lime		4270
Viola Lime & Chert		4300
Lime		4330
Lime & Chert		4356
Lime & Shale		4375
Lime		4410
Arbuckle Lime		4455
Total Depth		4455

This is to certify that the above information is to the best of my knowledge true and correct.

GLENN W. PEEL DRILLING COMPANY

BY: *Glenn W. Peel*

SUBSCRIBED AND SWORN TO before me this 20th day of May, 1960

My commission expires March 4, 1962.

Marion M. Herbert
Notary Public