


STATE OF KANSAS
STATE CORPORATION COMMISSION
CONSERVATION DIVISION
P. O. BOX 17027
WICHITA, KANSAS 67217

FORM CP-4

WELL PLUGGING RECORD

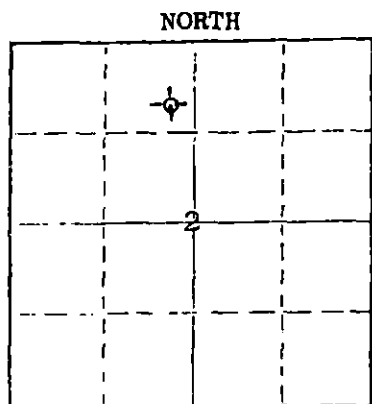

Locate well correctly on above Section Plot

Pratt County, Sec. 2 Twp. 26S Rge. 11W (SE) (W)

Location as "NE/CNW/SW" or footage from lines SE NE NW

Lease Owner Eufaula Enterprises, Inc.

Lease Name Durham Well No. 1

Office Address 4121 W. 83rd St., Prairie Village, Kansas 66208

Character of Well (completed as Oil, Gas or Dry Hole) Dry Hole

Date well completed October 17, 19 75

Application for plugging filed October 17, 19 75

Application for plugging approved October 17, 19 75

Plugging commenced October 17, 19 75

Plugging completed October 17, 19 75

Reason for abandonment of well or producing formation Dry Hole

If a producing well is abandoned, date of last production 19

Was permission obtained from the Conservation Division or its agents before plugging was commenced? Yes

Name of Conservation Agent who supervised plugging of this well

Producing formation Depth to top Bottom Total Depth of Well 4370 Feet

Show depth and thickness of all water, oil and gas formations.

OIL, GAS OR WATER RECORDS

CASING RECORD

FORMATION	CONTENT	FROM	TO	SIZE	PUT IN	PULLED OUT
		0'	272'	10-3/4"	272'	None

Describe in detail the manner in which the well was plugged, indicating where the mud fluid was placed and the method or methods used in introducing it into the hole. If cement or other plugs were used, state the character of same and depth placed, from feet to feet for each plug set.

Spotted with 35 sacks cement at 250',
solid bridge plug and 15 sacks cement
at 40', 2 sacks cement in rat hole.

(If additional description is necessary, use BACK of this sheet)

Name of Plugging Contractor

Address

STATE OF KANSAS COUNTY OF SEDGWICK

John D. Knightley Agent (employee of owner) or (owner or operator) of the above-described

well, being first duly sworn on oath, says: That I have knowledge of the facts, statements, and matters herein contained and the log of the above-described well as filed and that the same are true and correct. So help me God.

(Signature)

301 S. Broadway, Wichita, Kansas

(Address)

SUBSCRIBED AND SWORN TO before me this 21st day of October, 19 75

My commission expires March 12, 1979

Notary Public.

RECEIVED
STATE CORPORATION COMMISSION

OCT 22 1975

CONSERVATION DIVISION
Wichita, Kansas

Eufaula Enterprises, Inc. - Durham #1
SE NE NW Sec. 2-26S-11W
Pratt County, Kansas

Contractor: D. R. Lauck Oil Company, Inc.
301 S. Broadway
Wichita, Kansas 67202

Commenced: October 1, 1975
Completed: October 17, 1975

Drillers Log

Clay & Shale	60
Sand & Shale	185
Red Bed	272
Shale & Shells	1440
Shale & Lime	1870
Lime & Shale	2390
Shale & Lime	2585
Lime & Shale	3155
Lime	3400
Shale & Lime	3540
Lime	4080
Lime & Chert	4110
Lime	4300
Shale & Sand	4370 RTD

RECEIVED
STATE CORPORATION COMMISSION

OCT 22 1975

CONSERVATION DIVISION
Wichita, Kansas