

STATE OF KANSAS  
STATE CORPORATION COMMISSION  
200 Colorado Derby Building  
Wichita, Kansas 67202

WELL PLUGGING RECORD  
K.A.R.-82-3-117

15-063-20069-0000

API NUMBER N/A

LEASE NAME Sutcliffe 'AC'

WELL NUMBER 3

1980 Ft. from S Section Line

3300 Ft. from E Section Line

SEC. 12 TWP. 14S RGE. 27W (E) or (W)

COUNTY Gove

Date Well Completed 6-10-71

Plugging Commenced 11-17-87

Plugging Completed 11-17-87

TYPE OR PRINT  
NOTICE: Fill out completely  
and return to Cons. Div.  
office within 30 days.

LEASE OPERATOR Pickrell Drilling Company, Inc.

ADDRESS 110 North Market, Suite 205, Wichita, KS 67202

PHONE# (316) 262-8427 OPERATORS LICENSE NO. 5123

Character of Well Oil

(Oil, Gas, D&A, SWD, Input, Water Supply Well)

Did you notify the KCC/KDHE Joint District Office prior to plugging this well? Yes

Which KCC/KDHE Joint Office did you notify? Hays District Office

Is ACO-1 filed? Yes If not, is well log attached? \_\_\_\_\_

Producing Formation Kansas City Depth to Top 3814 Bottom 3904 T.D. 4331

Show depth and thickness of all water, oil and gas formations.

OIL, GAS OR WATER RECORDS

CASING RECORD

Formation	Content	From	To	Size	Put in	Pulled out
				8 5/8"	263'	None
				4 1/2"	4326'	None

Describe in detail the manner in which the well was plugged, indicating where the mud fluid was placed and the method or methods used in introducing it into the hole. If cement or other plugs were used, state the character of same and depth placed, from feet to feet each set.

Mixed & pumped 300% hulls w/water, mixed & pumped 150 sx Allied ATL cement with 100 sx hulls in first cement. Max & final pressure 500%. Shut well in with 500%.

(If additional description is necessary, use BACK of this form.)

Name of Plugging Contractor Allied Cementing License No. N/A

Address Box 31, Russell, Kansas 67665

STATE OF Kansas COUNTY OF Sedgwick, ss.

Jack Gurley, Engineer

(Employee of Operator) ~~XXXXXXXXXXXX~~ of above-described well, being first duly sworn on oath, says: That I have knowledge of the facts, statements, and matters herein contained and the log of the above-described well as filed that the same are true and correct, so help me God.

(Signature) Jack Gurley

(Address) Jack Gurley - Engineer

SUBSCRIBED AND SWORN TO before me this 1st day of December, 19 87

*[Handwritten Signature]*  
Notary Public  
My Commission Expires: 6-29-88

My Commission Expires: 6-29-88


Beth Harmon



STATE RECEIVED  
12-2-87  
CONSERVATION DIVISION  
Wichita, Kansas

New Completion  Workover

Oil Company \_\_\_\_\_ Well No. \_\_\_\_\_ Field \_\_\_\_\_ Lease \_\_\_\_\_  
 Company Man \_\_\_\_\_ Date Drilled \_\_\_\_\_ County \_\_\_\_\_ State \_\_\_\_\_

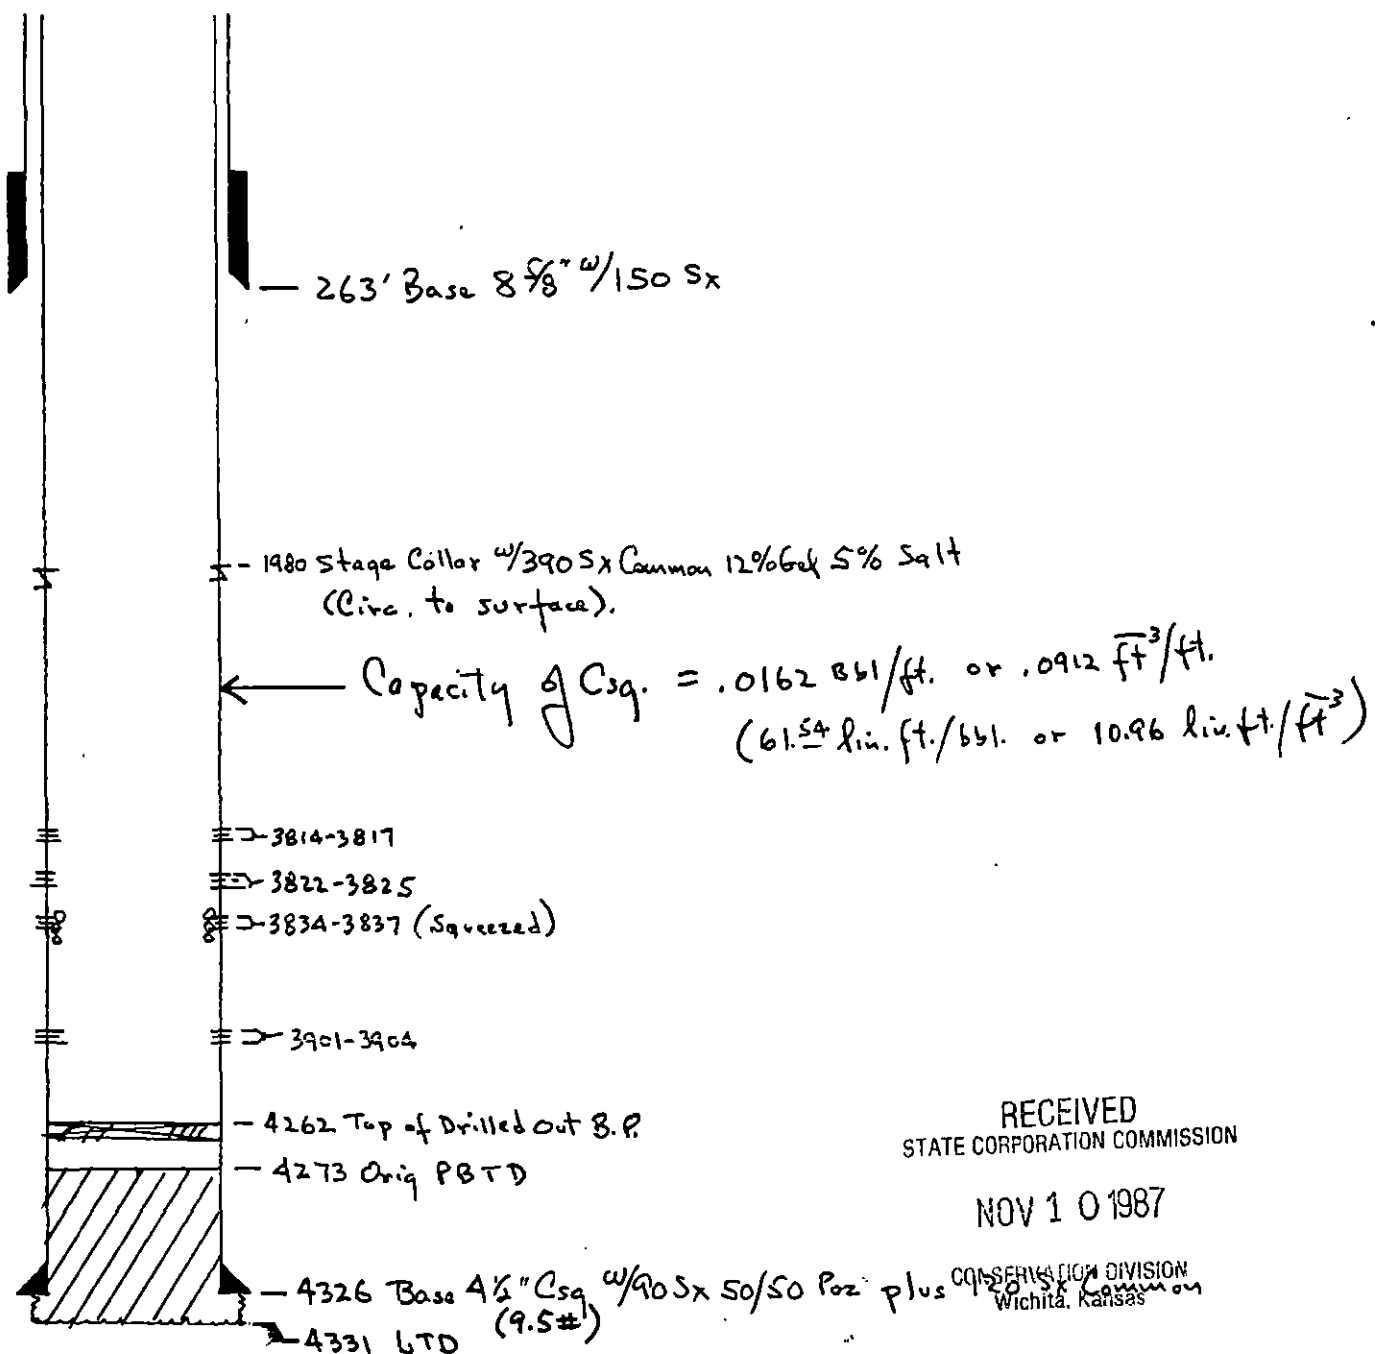

RECEIVED  
 STATE CORPORATION COMMISSION  
 NOV 10 1987  
 CONSERVATION DIVISION  
 WICHITA, KANSAS

REMARKS:

- Suggested Procedure:
- a) 3 Sx Hulls On Bottom
  - b) 25 Sx (31.25 ft<sup>3</sup>) 60/40 Pozmix 3904-3562 (342 ft.)
  - c) 36 1/2 Bbls. Mud containing 10 Sx Gel 3562 - 1316 (2246 ft.)
  - d) 100 Sx (125 ft<sup>3</sup>) 60/40 Pozmix 1316 - Surface (1316 ft.)