


Give all Information Completely  
Make Required Affidavit  
Mail or Deliver Report to:  
Conservation Division  
State Corporation Commission  
800 Bittling Building  
Wichita, Kansas

15-053-01621-0000  
**WELL PLUGGING RECORD**

NORTH

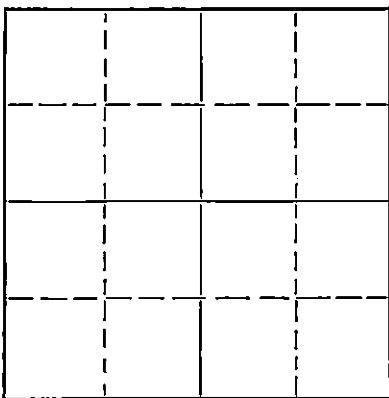

Locate well correctly on above  
Section Flat

Ellsworth County, Sec. 26 Twp. 17S Rge. 9 (W)  
Location as "NE/CNW $\frac{1}{4}$ SW $\frac{1}{4}$ " or footage from lines SW $\frac{1}{4}$   
Lease Owner Phillips Petroleum Company  
Lease Name Ogden Well No. 8  
Office Address Box 779 - Great Bend, Kansas  
Character of Well (completed as Oil, Gas or Dry Hole) Oil  
Date well completed March 28, 19 37  
Application for plugging filed August 10, 19 51  
Application for plugging approved August 11, 19 51  
Plugging commenced December 9, 19 51  
Plugging completed December 12, 19 51  
Reason for abandonment of well or producing formation Uneconomical to operate.

If a producing well is abandoned, date of last production July 24, 19 47  
Was permission obtained from the Conservation Division or its agents before plugging was commenced? Yes

Name of Conservation Agent who supervised plugging of this well Ruel Durkee  
Producing formation Arbuckle Depth to top 3168 Bottom 3181 Total Depth of Well 3181 Feet  
Show depth and thickness of all water, oil and gas formations.

OIL, GAS OR WATER RECORDS

CASING RECORD

| Formation | Content | From | To   | Size | Put In | Pulled Out |
|-----------|---------|------|------|------|--------|------------|
| Arbuckle  | Oil     | 3168 | 3181 | 10"  | 214'   | None       |
|           |         |      |      | 7"   | 3184'  | 2387'      |
|           |         |      |      |      |        |            |
|           |         |      |      |      |        |            |
Describe in detail the manner in which the well was plugged, indicating where the mud fluid was placed and the method or methods used in introducing it into the hole. If cement or other plugs were used, state the character of same and depth placed, from \_\_\_\_\_ feet to \_\_\_\_\_ feet for each plug set.  
Plugged back 3181' to 3160' with rock - dumped 6 sx. cement 3160-3130'. Mudded hole 3130' to 215'. Set rock bridge 215 to 205'. Dumped 20 sx. cement 205' to 165'. Mudded hole to 25'. Set rock bridge at 25' and dumped 5 sx. cement in filling to base of cellar. Well plugged and abandoned 2:00 PM. 12-12-51.

(If additional description is necessary, use BACK of this sheet)

Name of Plugging Contractor West Supply Company  
Address Chase, Kansas

STATE OF Kansas, COUNTY OF Barton, ss.  
A. J. Willis (employee of owner) of the above-described well,  
being first duly sworn on oath, says: That I have knowledge of the facts, statements, and matters herein contained and the log of the above-described well as filed and that the same are true and correct. So help me God.

(Signature) *A. J. Willis*  
Box 779 - Great Bend, Kansas (Address)

SUBSCRIBED AND SWORN TO before me this 13th day of December, 19 51

My commission expires November 18, 1953

23-8390-s 8-51-20M

**PLUGGING**  
FILE SEP 26 1951  
BOOK PAGE 102 LINE 8

*Joseph M. Beal*  
Notary Public.  
STATE OF KANSAS  
DEC 17 1951  
CONSERVATION DIVISION  
Wichita, Kansas

## Formation Record

15-053-01621-0000

Lease Ogden

Well No. 8

| FROM | TO   | Formation               | REMARKS             |
|------|------|-------------------------|---------------------|
| 0    | 120  | Shale and shells.       |                     |
| 120  | 214  | Sand Rock, Lime Shells. |                     |
| 214  | 370  | Lime, Shells.           |                     |
| 370  | 555  | Shale, Lime Streaks.    |                     |
| 555  | 615  | Shale, Lime Shells.     |                     |
| 615  | 790  | Shale, Shells.          |                     |
| 790  | 890  | Shale.                  |                     |
| 890  | 1120 | Salt.                   |                     |
| 1120 | 1180 | Shale.                  |                     |
| 1180 | 1300 | Lime Shells.            |                     |
| 1300 | 1385 | Shale.                  |                     |
| 1385 | 1465 | Shale, Lime Shells.     |                     |
| 1465 | 1505 | Shale.                  |                     |
| 1505 | 1590 | Lime.                   |                     |
| 1590 | 1655 | Broken Lime.            |                     |
| 1655 | 1760 | Shale, Lime Shells.     |                     |
| 1760 | 1820 | Broken Lime.            |                     |
| 1820 | 2390 | Shale.                  |                     |
| 2390 | 2835 | Lime.                   |                     |
| 2835 | 2858 | Shale.                  |                     |
| 2858 | 3000 | Lime.                   |                     |
| 3000 | 3065 | Shale.                  |                     |
| 3065 | 3160 | Lime.                   |                     |
| 3160 | 3166 | Green Shale. (Cored)    |                     |
| 3166 | 3169 | Lime. (Cored)           | Top Arbuckle 3168'. |
| 3169 | 3179 | Sandy Lime.             |                     |
| 3179 | 3181 | Lime.                   |                     |

|                 |      |      |   |
|-----------------|------|------|---|
| <b>PLUGGING</b> |      |      |   |
| FILE            | SEC  | T    | R |
| BOOK            | PAGE | LINE |   |

3179  
 3169  
 3166  
 3160  
 3065  
 3000  
 2858  
 2835  
 2390  
 1820  
 1760  
 1655  
 1590  
 1505  
 1465  
 1385  
 1300  
 1180  
 1120  
 890  
 790  
 615  
 555  
 370  
 214  
 0

DEC 7 1951