

WELL PLUGGING RECORD

Give All Information Completely
Make Required Affidavit
Mail or Deliver Report to:
Conservation Division
State Corporation Commission
800 Bitting Building
Wichita, Kansas

Pratt

County. Sec. 1 Twp. 26 Rge. 13 (E) (W)

Location as "NE/CNW $\frac{1}{4}$ SW $\frac{1}{4}$ " or footage from lines 330' From West line 330' from North line.

Lease Owner Lafayette Oil Company

Lease Name Chance Well No. 1

Office Address 125 W. 3rd. Tulsa 3, Okla.

Character of Well (completed as Oil, Gas or Dry Hole) ~~Oil~~ Dry Hole

Date well completed April 21, 1953 19

Application for plugging filed April 28, 1953 19

Application for plugging approved April 27, 1953 19


Plugging commenced May 4, 1953 19

Plugging completed May 11, 1953 19

Reason for abandonment of well or producing formation Dry hole

If a producing well is abandoned, date of last production 19

Was permission obtained from the Conservation Division or its agents before plugging was commenced? Yes

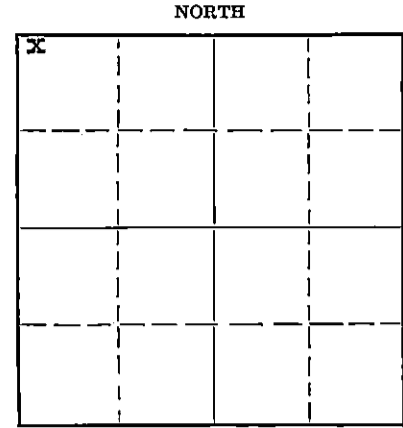

Locate well correctly on above Section Plat

Name of Conservation Agent who supervised plugging of this well Mr. M. A. Rives

Producing formation None Depth to top Bottom Total Depth of Well 4341' Feet

Show depth and thickness of all water, oil and gas formations.

OIL, GAS OR WATER RECORDS

CASING RECORD

Formation	Content	From	To	Size	Put In	Pulled Out
Shale	This surface pipe was cemented with	325	Sks.	8 5/8"	3/24/53	Cemented in
4 1/2" Casing	was set at 3900' cemented with 125 Sks. The pipe was perforated from 3838' to 3844'	3600'	Perforated pipe from 3566' to 3570'			
	Set Bridging plug at 3600'					

Describe in detail the manner in which the well was plugged, indicating where the mud fluid was placed and the method or methods used in introducing it into the hole. If cement or other plugs were used, state the character of same and depth placed, from feet to feet for each plug set.

Plugged hole from 3600' back to 4342' with sand, Dumped Five (5) Sacks of cement on sand with dump bailed. Then plugged hole with heavy mud up to 270' Set rock bridge, Squeezed well with Twenty (20) Sacks of mud and Eighty (80) Sacks of cement. The top of rock plug was 250' Work was completed May 11, 1953

(If additional description is necessary, use BACK of this sheet)

Name of Plugging Contractor Forbes Casing Pulling Co.
Address P.O. Box 221 Great Bend, Kans.

STATE OF Kansas, COUNTY OF Pratt, ss.
James R. Pryor (employee of owner) or (owner or operator) of the above-described well,

being first duly sworn on oath, says: That I have knowledge of the facts, statements, and matters herein contained and the log of the above-described well as filed and that the same are true and correct. So help me God.

(Signature) James R. Pryor
(Address) Box 470 Great Bend Kans.

SUBSCRIBED AND SWORN to before me this 26 day of May, 1953

My commission expires Oct 17, 1955
Isabella Beakey Notary Public.

23-8390-s 6-51-20M

PLUGGING

FILE SEC 1 T 26 R 13 W
BOOK PAGE 96 LINE 9

MAY 27 1953
CONSERVATION DIVISION
Wichita, Kansas

RECEIVED
 APR 20 1953
 TULSA, OKLA.

DRILLERS LOG

Chance #1
 Commenced R.D.: 3-23-53
 Completed R.D.: 4-14-53
 Total Depth: 4341'
 Casing Record: 494' of 8 5/8"

NW NW NW, Block 4
 Sec. 1-26-13
 Pratt County, Kansas
 Elevation: 1900 KB
 Initial Prod.: Kansas City
 Contractor: Buick Drilling Inc.

STRATA	DEPTH
Surface soil	0 - 40
Surface sand	40 - 60
River sand	60 - 125
Blue clay, gravel	125 - 175
Red bed	175 - 430
Shells, sand	430 - 455
Shale	455 - 494
Red bed	494 - 675
Red bed, sand	675 - 745
Anhydrite	745 - 775
Shale	775 - 965
Shale and shells	965 - 1180
Sandy shale	1180 - 1215
Salt shale	1215 - 1280
Salt shale	1280 - 1575
Shale	1575 - 1743
Lime and shale	1743 - 2080
Lime	2080 - 2102
Lime and shale	2102 - 2590
Shale	2590 - 2710
Lime and shale	2710 - 2855
Shale	2855 - 2960
Lime and shale	2960 - 3445
Lime	3445 - 3495
Lime and shale	3495 - 3680
Lime	3680 - 3715
Lime and shale	3715 - 3735
Lime	3735 - 3760
Lime and shale	3760 - 3830
Lime	3830 - 3893
Lime and shale	3893 - 3933
Lime	3933 - 3966
Lime and shale	3966 - 4000
Shale, lime and chert	4000 - 4035
Lime and chert	4035 - 4065
Lime	4065 - 4095
Lime and chert	4095 - 4140
Chert	4140 - 4261
Lime and shale	4261 - 4288
Shale	4288 - 4341 T.D.

RECEIVED
 PLUGGING
 ALL SEC 1 T 26 R 134
 BOOK PAGE 26 LINE 9

I hereby certify the above a true and correct drilling log as reflected by the drilling reports of the Buick Drilling Inc.

BUICK DRILLING INC.

H. R. Buick
 H. R. Buick, President

Signed and sworn to in my presence this 17th day of April, 1953, by H. R. Buick, President of the Buick Drilling Inc.

My commission expires December 26, 1955

Robert Shogren
 Notary Public