


STATE OF KANSAS
STATE CORPORATION COMMISSION

WELL PLUGGING RECORD

Give All Information Completely
Make Required Affidavit
Mail or Deliver Report to:
Conservation Division
State Corporation Commission
800 Bittling Building
Wichita, Kansas

Pratt County, Sec. 8 Twp 26 Rge. 13 (E) (W)
Location as "NE/CNW%SW%" or footage from lines SE NW SW
Lease Owner McKnab Drilling, Inc.
Lease Name Donner Well No. 1
Office Address 503 Union National Bank Building, Wichita, Kansas
Character of Well (completed as Oil, Gas or Dry Hole) Dry Hole
Date well completed October 29 1955
Application for plugging filed October 29 1955
Application for plugging approved October 29 1955
Plugging commenced 7:00 P.M. - October 29 1955
Plugging completed 10:30 P.M. - October 29 1955
Reason for abandonment of well or producing formation _____

NORTH

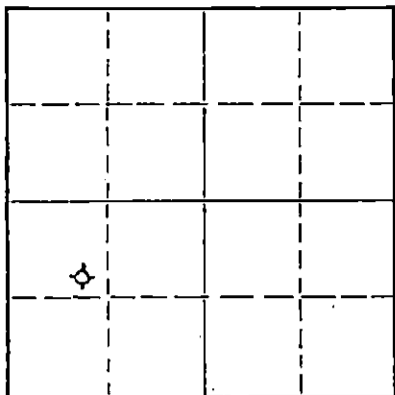

Locate well correctly on above
Section Plat

If a producing well is abandoned, date of last production _____ 19____
Was permission obtained from the Conservation Division or its agents before plugging was com-
menced? Yes

Name of Conservation Agent who supervised plugging of this well M. A. Rives
Producing formation _____ Depth to top _____ Bottom _____ Total Depth of Well _____ Feet
Show depth and thickness of all water, oil and gas formations.

OIL, GAS OR WATER RECORDS

CASING RECORD

FORMATION	CONTENT	FROM	TO	SIZE	PUT IN	PULLED OUT
Red Bed	8 5/8"	0	381'		10-12-55	

Describe in detail the manner in which the well was plugged, indicating where the mud fluid was placed and the method or methods used in introducing it into the hole. If cement or other plugs were used, state the character of same and depth placed, from _____ feet to _____ feet for each plug set.

Gunned up pits - circ heavy mud around - layed down all but ten joints drill pipe - Filled hole with mud to 300' - put 1 1/2 sacks hulls in ahead of HOWCO plug set @ 300' and cement with 20 sacks cement through drill pipe on bottom plug - Filled hole with mud to 35' put 2 gallons hulls in sack ahead of top plug - set HOWCO Top Plug @ 35' and tied with wire line - Mixed 10 sacks cement on plug.

RECEIVED
NOV 1 1955
CONSERVATION DIVISION
STATE CORPORATION COMMISSION
WICHITA, KANSAS

(If additional description is necessary, use BACK of this sheet)

Name of Plugging Contractor _____
Address _____

STATE OF KANSAS, COUNTY OF SEDGWICK, ss.
Don Gardner (employee of owner) or (owner/operator) of the above-described well, being first duly sworn on oath, says: That I have knowledge of the facts, statements, and matters herein contained and the log of the above-described well as filed and that the same are true and correct. So help me God.

(Signature) [Signature]
503 Union National Bank Building, Wichita, Kansas
(Address)

SUBSCRIBED AND SWORN TO before me this 7th day of November, 1956

Helen L. Long
Notary Public.

My commission expires November 21, 1956

PLUGGING
FILE SEC-8 T26 R13W
BOOK PAGE 12 LINE 18

DRILLER'S LOG

McKnab Drilling, Inc.

Donner #1

SE NW SW Sec 8-26S-13W

Pratt County, Kansas

<u>TO</u>	<u>FROM</u>	
0	55	Sand Surface Clay
55	135	Sand
135	245	Shale
245	845	Red Bed & Shale
845	890	Anhydrite
890	1125	Shale & Shells
1175	1200	Shale
1200	1350	Shale & Shells
1350	1610	Shale & Shells
1610	1775	Shale
1775	1810	Lime & Shale
1810	1950	Lime
1950	2260	Lime
2260	3585	Lime & Shale
3585	3735	Lime
3735	3765	Shale
3765	4086	Lime
4086	4140	Lime & Shale
4140	4265	Lime
4265	4294	Cherty Lime
4294	4350	Viola Lime
4350	4370	Cherty Lime
4370	4411	Shale
4411	4450	Lime & Shale
4450	4476	Arbuckle Lime
	4476	ROTARY TOTAL DEPTH
		D & A

COMMENCED: 10-13-55
COMPLETED: 10-29-55

CASING RECORD

Set 379' 8 5/8" surface casing with 290 sacks cement and 1 % c.c.

RECEIVED BY
STATE OF KANSAS
NOV 11 1955
GEO. ...


STATE OF KANSAS)
) SS
COUNTY OF SEDGWICK)

I hereby affirm that the above and foregoing is a true and correct copy of the log of the Donner #1 located in the SE/4 of the NW/4 of the SW/4 of Section 8, Township 26 South, Range 13 West, Pratt County, Kansas.

McKNAB DRILLING, INC.


Don Gardner

Subscribed and sworn to before me this 7th day of November, 1955.

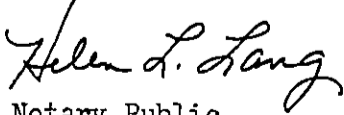
Helen L. Lang
Notary Public

My commission expires November 21, 1956.

PLUGGING
WELL SEC-8-T-26-R-13W
BOOK PAGE 12 LINE 18