


STATE OF KANSAS  
STATE CORPORATION COMMISSION

WELL PLUGGING RECORD

Give All Information Completely  
Make Required Affidavit  
Mail or Deliver Report to  
Conservation Division  
State Corporation Comm.  
245 North Water  
Wichita, KS 67202

Pratt County, Sec. 8 Twp. 26 Rge. 13 E/W  
Location as "NE/CNW $\frac{1}{2}$ SW $\frac{1}{2}$ " or footage from lines \_\_\_\_\_

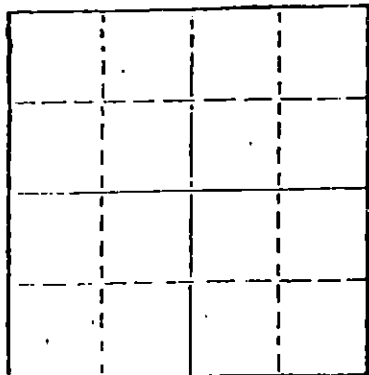

Locate well correctly on above  
Section Plot

NW NE NE  
Lease Owner Raymond Oil Co., Inc.  
Lease Name SNYDER Well No. 1  
Office Address Suite 800, 200 West Douglas, Wichita, Ks. 67202  
Character of Well (Completed as Oil, Gas or Dry Hole) \_\_\_\_\_

Dry Hole  
Date Well completed March 5 19 79  
Application for plugging filed March 5 19 79  
Application for plugging approved March 5 19 79  
Plugging commenced March 6 19 79  
Plugging completed March 6 19 79  
Reason for abandonment of well or producing formation \_\_\_\_\_

If a producing well is abandoned, date of last production  
19 \_\_\_\_\_

Was permission obtained from the Conservation Division or  
its agents before plugging was commenced? yes

Name of Conservation Agent who supervised plugging of this well William Owens  
Producing formation \_\_\_\_\_ Depth to top \_\_\_\_\_ Bottom \_\_\_\_\_ Total Depth of Well 4085'  
Show depth and thickness of all water, oil and gas formations.

OIL, GAS OR WATER RECORDS

CASING RECORD

FORMATION	CONTENT	FROM	TO	SIZE	PUT IN	PULLED OUT

Describe in detail the manner in which the well was plugged, indicating where the mud fluid was placed and the method or methods used in introducing it into the hold. If cement or other plugs were used, state the character of same and depth placed, from \_\_\_\_\_ feet to \_\_\_\_\_ feet for each plug set.

Bottom plug @ 540' w/ 50 sacks cement thru drill pipe  
Middle Plug @ 300' w/ 40 sacks cement thru drill pipe  
Top plug @ 40'  $\frac{1}{2}$  sacks hulls f/bridge and 12 sks. cement.  
3 sacks cement in rat hole

RECEIVED  
STATE CORPORATION COMMISSION

MAR - 8 1979

CONSERVATION DIVISION  
Wichita, Kansas

(If additional description is necessary, use BACK of this sheet)

Name of Plugging Contractor Duke Drilling Co., Inc.

STATE OF Kansas COUNTY OF Barton, ss.  
Bill Draney (employee of owner) or (owner or operator)  
of the above-described well, being first duly sworn on oath, says: That I have knowledge of the facts, statements, and matters herein contained and the log of the above-described well as filed and that the same are true and correct. So help me God.

(Signature) Bill Draney  
Box 823 - Great Bend, Ks. 67530  
(Address)

SUBSCRIBED AND SWORN TO before me this 7 day of March, 19 79

Dorothy M. Hague  
Notary Public.

My commission expires April-11-1982

DRILLERS' WELL LOG

DATE COMMENCED: February 26, 1979  
DATE COMPLETED: March 5, 1979

Raymond Oil Co., Inc.  
SNYDER #1  
NW NE NE  
Sec. 8-T26S-R13W  
Pratt County, Kansas

ELEVATION: 1950 K.B.

0 - 190'	Shale, Sand Streaks
190 - 294'	Red Bed
294 - 849'	Shale
849 - 865'	Anhydrite
865 - 1690'	Shale
1690 - 2942'	Shale & Lime
2942 - 3227'	Lime & Shale
3227 - 3583'	Lime
3583 - 3589'	Shale
3589 - 3603'	Lime & Shale
3603 - 3629'	Lime
3629 - 3745'	Shale
3745 - 3777'	Lime & Shale
3777 - 4080'	Lime
4080 - 4085'	Lime & Shale
4085'	RTD

FORMATION DATA

ANHYDRITE	849
TOPEKA	3227
HEEBNER	3583
TORONTO	3603
DOUGLAS	3629
HR. LIME	3745
LANSING KC	3777
BASE KC	4080
RTD	4085

SURFACE PIPE: Set new  
24# pipe @ 294' w/225  
common, 2% Gel, 3% cc.

A F F I D A V I T

STATE OF KANSAS  
COUNTY OF BARTON ) ss

Bill Draney, of lawful age does swear and state that the facts and statements  
herein contained are true and correct to the best of his knowledge.

RECEIVED  
STATE CORPORATION COMMISSION  
MAR - 6 1979  
CONSERVATION DIVISION  
Topeka, Kansas

Bill Draney

Subscribed and sworn to before me this 7<sup>th</sup> day of March 1979.

Dorothy M. Hague  
Notary Public

My Commission Expires:  
April 11 1982