


STATE OF KANSAS
STATE CORPORATION COMMISSION

Give All Information Completely
Make Required Affidavit
Mail or Deliver Report to:
Conservation Division
State Corporation Commission
800 Biting Building
Wichita, Kansas

WELL PLUGGING RECORD

NORTH

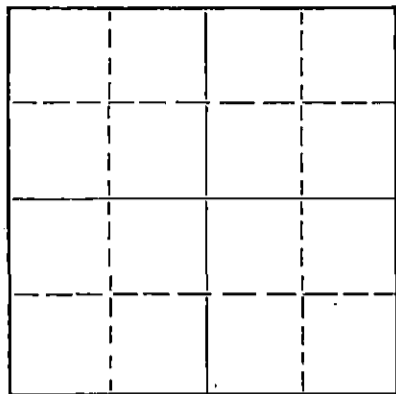

Locate well correctly on above
Section Plat

Pratt

County. Sec. 3 Twp. 26 Rge. (E) 13 (W)

Location as "NE/CNW%SW%" or footage from lines C of SW 10 A. of Lot 4

Lease Owner M. B. Armer

Lease Name Fincham Well No. 1

Office Address 710 Petroleum Bldg., Wichita, Kansas

Character of Well (completed as Oil, Gas or Dry Hole) Dry Hole

Date well completed Dec. 15, 19 54

Application for plugging filed " " 19 "

Application for plugging approved " " 19 "

Plugging commenced " " 19 "

Plugging completed " " 19 "

Reason for abandonment of well or producing formation Dry

If a producing well is abandoned, date of last production 19

Was permission obtained from the Conservation Division or its agents before plugging was commenced? Yes

Name of Conservation Agent who supervised plugging of this well M. A. Rives

Producing formation Depth to top Bottom Total Depth of Well 4452 Feet

Show depth and thickness of all water, oil and gas formations.

OIL, GAS OR WATER RECORDS

CASING RECORD

FORMATION	CONTENT	FROM	TO	SIZE	PUT IN	PULLED OUT
				8 5/8"	337'	None

Describe in detail the manner in which the well was plugged, indicating where the mud fluid was placed and the method or methods used in introducing it into the hole. If cement or other plugs were used, state the character of same and depth placed, from feet to feet for each plug set.

Filled hole with heavy Rotary Mud to 300 ft.

Set plug, 1/2 sacks hulls and cemented with 20 sacks

cement through drill pipe. Filled hole with Rotary

mud to 35 ft., set plug and 1/2 sack hulls and 10 sacks

cement at the surface.

(If additional description is necessary, use BACK of this sheet)

Name of Plugging Contractor M. B. Armer

Address Wichita, Kansas

STATE OF KANSAS, COUNTY OF SEDGWICK, ss.

L. C. Sponenberg (employee of owner) or (owner or operator) of the above-described

well, being first duly sworn on oath, says: That I have knowledge of the facts, statements, and matters herein contained and the log of the above-described well as filed and that the same are true and correct. So help me God.


(Signature) L. C. Sponenberg

(Address)

SUBSCRIBED AND SWORN TO before me this 17th day of December, 19 54

My commission expires February 13, 1954.

Rose Lurey Notary Public.

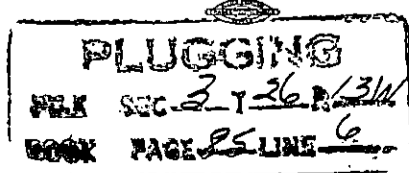

KANSAS GEOLOGICAL SOCIETY
KANSAS WELL LOG BUREAU - KANSAS WELL SAMPLE BUREAU
 KANSAS GEOLOGICAL SOCIETY BUILDING
 508 EAST MURDOCK - WICHITA, KANSAS

COMPANY **M. B. Armer**

SEC. **3** T. **26S** R. **13W**
 LOC. **SW SW NW**

FARM **Fincham**

NO. **1**

TOTAL DEPTH **4452'**

COMM. **11/29/54**

COMP. **12/15/54**


SHOT OR TREATED

CONTRACTOR **M. B. Armer**

ISSUED

COUNTY **Pratt**

KANSAS

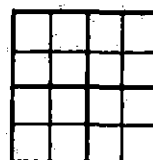

CASING

20	10	
15	8	336'
12	6	
13	5	

ELEVATION **1935 K.B.**

PRODUCTION **D & A**

FIGURES INDICATE BOTTOM OF FORMATIONS

Sand	205
Red Bed	805
Anhydrite	825
Red Bed, Shale & Shells	1165
Shale & Shells	1740
Shale, Shells & Salt	1800
Lime	2335
Shale & Lime	3370
Broken Lime	3500
Lime	3590
Lime & Shale	3732
Lime	3820
Shale & Lime	3851
Lime	3877
Lime & Shale	3914
Lime	4115
Lime & Shale	4185
Cherty Lime	4230
Shale	4243
Cherty Lime	4308
Lime	4332
Sand, Shale & Lime	4392
Lime	4452

FORMATION TOPS (K. B. Meas.)

HEEBNER	3551
TORONTO	3568
DOUGLAS	3612
BROWN LIME	3715
LANSING-KANSAS CITY	3740
MISSISSIPPI	4163
KINDERHOOK	4225
VIOLA	4243
SIMPSON SHALE	4331
SIMPSON SAND	4334
ARBUCKLE	4417

I hereby certify that this is a true and correct log of the above described well as shown by the drilling reports.

M. B. ARMER

By *L. C. Sporenberg*
 L. C. Sporenberg

PLUGGING

STATE OF KANSAS

COUNTY OF SEDGWICK

SS:

FILE SEC. **3** T. **26S** R. **13W**
 BOOK PAGE **15** LINE **6**

Subscribed and sworn to before me, a notary public, in and for said County and State this 20th day of December, 1954.

My Commission expires February 13, 1956.

Lois Lacey
 Notary Public