


K

STATE OF KANSAS  
STATE CORPORATION COMMISSION

Give All Information Completely  
Make Required Affidavit  
Mail or Deliver Report to:  
Conservation Division  
State Corporation Commission  
211 No. Broadway  
Wichita, Kansas

WELL PLUGGING RECORD

Pratt County. Sec. 3 Twp. 26 Rge. 13 (E) (W) x  
Location as "NE/CNW/SW" or footage from lines. C SE SE  
Lease Owner Imperial Oil of Kansas, Inc.  
Lease Name Dale Wood Well No. #1  
Office Address Box 97, Wakeeney, Kansas  
Character of Well (completed as Oil, Gas or Dry Hole) \_\_\_\_\_  
Date well completed \_\_\_\_\_ 19\_\_\_\_  
Application for plugging filed \_\_\_\_\_ 19\_\_\_\_  
Application for plugging approved \_\_\_\_\_ 19\_\_\_\_  
Plugging commenced 7-11-62 19\_\_\_\_  
Plugging completed 7-16-62 19\_\_\_\_  
Reason for abandonment of well or producing formation \_\_\_\_\_  
If a producing well is abandoned, date of last production \_\_\_\_\_ 19\_\_\_\_  
Was permission obtained from the Conservation Division or its agents before plugging was commenced? \_\_\_\_\_

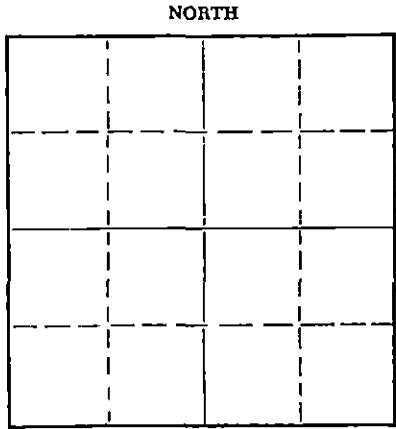

Locate well correctly on above Section Plat

Name of Conservation Agent who supervised plugging of this well Herman E. Gustus  
Producing formation \_\_\_\_\_ Depth to top \_\_\_\_\_ Bottom \_\_\_\_\_ Total Depth of Well 4135 Feet  
Show depth and thickness of all water, oil and gas formations.

OIL, GAS OR WATER RECORDS

CASING RECORD

FORMATION	CONTENT	FROM	TO	SIZE	PUT IN	PULLED OUT

Describe in detail the manner in which the well was plugged, indicating where the mud fluid was placed and the method or methods used in introducing it into the hole. If cement or other plugs were used, state the character of same and depth placed, from \_\_\_\_\_ feet to \_\_\_\_\_ feet for each plug set.

Sanded back to 3750' mixed and dumped 3 sacks cement.  
Mudded hole to 400' - bailed fluid down. Set bridge at 400' and dumped 3 yards of ready mix concrete. Mixed and dumped 5 sacks cement for top cap.

RECEIVED  
STATE CORPORATION COMMISSION  
JUL 17 1962  
CONSERVATION DIVISION  
Wichita, Kansas

(If additional description is necessary, use BACK of this sheet)  
Name of Plugging Contractor Southwest Casing Pulling Co., Inc.  
Address Box 364, Great Bend, Kansas

STATE OF Kansas, COUNTY OF Barton, ss.  
Southwest Casing Pulling Co., Inc. (employee of owner) or (owner or operator) of the above-described well, being first duly sworn on oath, says: That I have knowledge of the facts, statements, and matters herein contained and the log of the above-described well as filed and that the same are true and correct. So help me God.

(Signature) W. C. Spencer Sec.  
Box 364, Great Bend, Kansas  
(Address)

SUBSCRIBED AND SWORN to before me this 17 day of July, 19 62

My commission expires 24 October 1964  
Sidney D. Miller  
Notary Public.



**DRILLERS LOG**

#1 Woods

CASING RECORD:  
432' of new 8-5/8"  
surface casing

COMPANY: Nadel & Gussman &  
Strata  
CONTRACTOR: Strata Drilling, Inc. Pratt County, Kansas

DESCRIPTION: C/SE SE  
Section 3-26-13W  
Pratt County, Kansas

TOTAL DEPTH:  
4425'

COMMENCED: June 12, 1962  
COMPLETED: June 24, 1962

ELEVATION: 1925' KB

<u>FORMATION</u>	<u>FROM</u>	<u>TO</u>	<u>REMARKS</u>
Sand & Clay	0	195	Ran 432' of new 8-5/8" surface casing; set and cemented at 432' with 175 sacks of regular cement, 5% gel and 2% C. C. Cement did not circulate. Set 100 sacks of cement, 2% gel and 2% C. C. Plug down at 10:30 A. M. June 13, 1962.
Red Bed	195	772	
Anhydrite	772	797	
Shale & Shells	797	838	
Shale	838	890	
Shale & Shells	890	1725	
Lime & Shale	1725	3561	
Lime	3561	4010	
Shale & Lime	4010	4140	
Shale & Chert	4140	4175	
Cherty Lime	4175	4241	
Chert	4241	4288	
Sand & Shale	4288	4333	
Lime & Shale	4333	4425	

Total Depth 4425'

**RECEIVED**  
STATE CORPORATION COMMISSION

JUL 12 1962

CONSERVATION DIVISION  
Wichita, Kansas

Ran Welox Log.

Ran 117 Joints of 4 1/2" pipe; set and cemented with 125 sacks of posmix, 18 lbs. of salt per sack of posmix. Set at 3814'. Plug down at 3:00 P. M. June 24, 1962.

STATE OF KANSAS )  
                          ) ss.  
COUNTY OF BARTON )

I certify that this is a true and correct copy of the above log to the best of my knowledge.

STRATA DRILLING, INC.

*Jim B. McWilliams*  
Jim B. McWilliams

Subscribed and sworn to before me this 25th day of June, 1962.

*Elaine H. Taylor*  
Elaine H. Taylor, Notary Public

My Commission Expires:

December 14, 1965