

STATE OF KANSAS  
STATE CORPORATION COMMISSION


Form CP-4

Give All Information Completely  
Make Required Affidavit  
Mail or Deliver Report to:  
Conservation Division  
State Corporation Commission  
212 No. Market  
Wichita, Kansas 67202

WELL PLUGGING RECORD

Pratt County. Sec. 3 Twp. 26S Rge. (E) 13 (W)

Location as "NE/CNW/SW" or footage from lines Ap C SE SW  
Lease Owner Jack R. Sowles & John B. McCloud  
Lease Name Woods Well No. 1-B  
Office Address 2426 N.E. Broadway, Portland, Oregon  
Character of Well (completed as Oil, Gas or Dry Hole) Dry Hole  
Date well completed March 21, 19 71  
Application for plugging filed 19  
Application for plugging approved 19  
Plugging commenced March 21, 19 71  
Plugging completed March 21, 19 71  
Reason for abandonment of well or producing formation Dry Hole

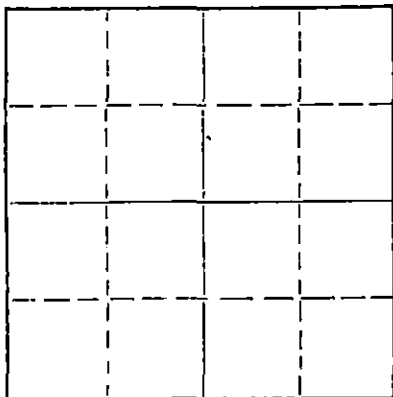

Locate well correctly on above Section Plat

If a producing well is abandoned, date of last production 19  
Was permission obtained from the Conservation Division or its agents before plugging was commenced? Yes (G. Russell Biberstein of Attica)

Name of Conservation Agent who supervised plugging of this well \_\_\_\_\_  
Producing formation \_\_\_\_\_ Depth to top \_\_\_\_\_ Bottom \_\_\_\_\_ Total Depth of Well 4440 Feet  
Show depth and thickness of all water, oil and gas formations.

OIL, GAS OR WATER RECORDS

CASING RECORD

FORMATION	CONTENT	FROM	TO	SIZE	PUT IN	PULLED OUT
	Surface Casing	0	497'	8-5/8"	497'	-----

Describe in detail the manner in which the well was plugged, indicating where the mud fluid was placed and the method or methods used in introducing it into the hole. If cement or other plugs were used, state the character of same and depth placed, from \_\_\_\_\_ feet to \_\_\_\_\_ feet for each plug set.

Mud from Total Depth to 450 Feet,  
Plug and 35 sax Cement; Mud to 40  
Feet, 1/2 sax Halls & Plug Bridged  
& 10 sax Cement to Base of Cellar;  
2 sax Cement in Rat Hole. Job  
completed @ 6:15 P.M.

RECEIVED  
STATE CORPORATION COMMISSION  
MAR 24 1971  
CONSERVATION DIVISION  
Wichita, Kansas

(If additional description is necessary, use BACK of this sheet)

Name of Plugging Contractor Sage Drilling Co., Inc.  
Address 500 Bitting Building, Wichita, Kansas 67202


STATE OF KANSAS, COUNTY OF SEDGWICK, ss.  
Clarence Michael of Sage Drilling Co. (employee of owner) or (owner or operator) of the above described well, being first duly sworn on oath, says: That I have knowledge of the facts, statements, and matters herein contained and the log of the above-described well as filed and that the same are true and correct. So help me God.

(Signature) Clarence Michael  
500 Bitting Bldg., Wichita, Kansas 67202  
(Address)

Subscribed and sworn to before me this 22nd day of March, 19 71

My commission expires November 26, 1974.

Louise K. Whitted  
Notary Public.

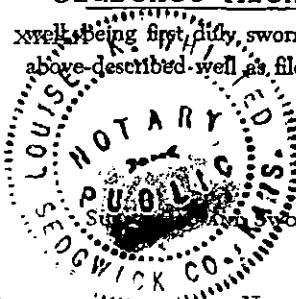

RECEIVED  
STATE CORPORATION COMMISSION  
MAR 24 1971  
CONSERVATION DIVISION  
Wichita, Kansas

DRILLERS LOG

WOODS NO. 1-B

CASING RECORD: OPERATOR: Sowles & McCloud DESCRIPTION:  
8-5/8" @ 497' CONTRACTOR: Sage Drilling Co. Ap C SE SW  
w/450 sax cement COMMENCED: March 12, 1971 Sec. 3-26S-13W  
Pratt County, Kansas  
TOTAL DEPTH: COMPLETED: March 21, 1971 ELEVATION: 1924 KB  
4440'

<u>FORMATION</u>	<u>FROM</u>	<u>TO</u>	<u>REMARKS</u>
Sand & Clay	0	40	
Sand	40	190	
Red Bed	190	567	
Red Bed, Shale & Shells	567	1225	
Shale & Lime	1225	1865	
Lime & Shale	1865	2110	
Lime	2110	2313	
Lime & Shale	2313	2500	
Shale & Lime	2500	3375	
Lime & Shale	3375	3550	
Shale, Lime & Sand	3550	3762	
Lime	3762	4040	
Lime & Chert	4040	4051	
Lime & Shale	4051	4145	
Lime & Chert	4145	4440	D&A

I certify that this is a true and correct copy of the above log to the best of my knowledge.

SAGE DRILLING CO., INC.

By Clarence Michael  
Clarence Michael



Subscribed and sworn to before me this 22nd day of March, 1971.

Louise K. Whitted  
Louise K. Whitted - Notary Public

My commission expires:  
November 26, 1971.