


STATE OF KANSAS
STATE CORPORATION COMMISSION

Give All Information Completely
Make Required Affidavit
Mail or Deliver Report to:
Conservation Division
State Corporation Commission
800 Bittling Building
Wichita, Kansas

WELL PLUGGING RECORD

NORTH

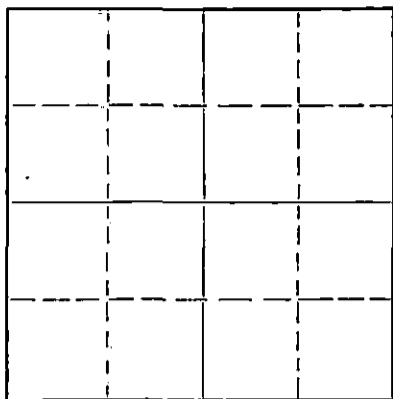

Locate well correctly on above
Section Flat

Pratt County. Sec. 21 Twp. 26S Rge. (E) 11(W)
Location as "NE/CNW&SWW" or footage from lines SE SW NE
Lease Owner Morrison Drilling Company, Inc.
Lease Name Hartman Well No. 1
Office Address Drawer 712, El Dorado, Kansas
Character of Well (completed as Oil, Gas or Dry Hole) Dry Hole
Date well completed May 5 19 53
Application for plugging filed Verbal May 5 19 53
Application for plugging approved Written May 7 19 53
Plugging commenced May 5 19 53
Plugging completed May 5 19 53
Reason for abandonment of well or producing formation

If a producing well is abandoned, date of last production 19
Was permission obtained from the Conservation Division or its agents before plugging was commenced? Yes

Name of Conservation Agent who supervised plugging of this well M. D. Rives, Pratt, Kansas
Producing formation Depth to top Bottom Total Depth of Well 4520 Feet
Show depth and thickness of all water, oil and gas formations.

OIL, GAS OR WATER RECORDS

CASING RECORD

FORMATION	CONTENT	FROM	TO	SIZE	PUT IN	PULLED OUT
				8 5/8	318	- 0 -

Describe in detail the manner in which the well was plugged, indicating where the mud fluid was placed and the method or methods used in introducing it into the hole. If cement or other plugs were used, state the character of same and depth placed, from feet to feet for each plug set.

Filled hole with rotary mud to 270' of top. Set Halliburton plug and filled with with hulls and 20 sacks of cement through drill pipe. Filled with rotary mud to 35' of top. Set Halliburton plug and hulls and 10 sacks of cement to surface.

RECEIVED
STATE CORPORATION COMMISSION
MAY 15 1953
CONSERVATION DIVISION
Wichita, Kansas

(If additional description is necessary, use BACK of this sheet)
Name of Plugging Contractor Morrison Drilling Company, Inc.
Address Drawer 712, El Dorado, Kansas

STATE OF KANSAS, COUNTY OF BUTLER, ss.
C. W. Wilson (employee of owner) or (owner or operator) of the above-described well, being first duly sworn on oath, says: That I have knowledge of the facts, statements, and matters herein contained and the log of the above-described well as filed and that the same are true and correct. So help me God.
(Signature) [Signature]
Drawer 712, El Dorado, Kansas (Address)

SUBSCRIBED AND SWORN TO before me this 12th day of May, 19 53
[Signature] Notary Public.

My commission expires January 10, 1955.

PLUGGING
FILE SEC 21 T 26 R 11W
BOOK PAGE 99 LINE 30

WELL LOG - Hartman #1

OPERATOR: Morrison Drilling Company, Inc.
 P. O. Drawer 712
 El Dorado, Kansas

LOCATION: SE SW NE
 Section 21-26S-11W
 Pratt County, Kansas

CONTRACTOR: Morrison Drilling Company, Inc.
 Drawer 712
 El Dorado, Kansas

PRODUCTION: D & A

Farm: Hartman Well No. 1

Date Commenced: April 14, 1953

Date Completed: May 5, 1953

Total Depth: 4520 feet - Rotary

Elevation: 1833 R.B.

<u>From</u>	<u>To</u>	<u>Formation</u>	<u>FORMATION TOPS</u>	
0	40	Sand	Topeka	3085
40	100	Sand	Heebner	3439
100	318	Shale & Shells	Douglas	3485
250	318	Plug & Cement	Br. Lime	3616
318	430	Sand	Lansing-K.C.	3635
430	480	Red Bed	Mississippian	4085
480	580	Sand	Kinderhook Sh.	4195
580	830	Red Bed	Viola	4300
830	1805	Shale & Shells	Simpson	4397
1805	1885	Lime & Shale	Arbuckle	4474
1885	2310	Lime		
2310	2745	Lime & Shale		
2745	2840	Shale & Lime shells		
2840	3271	Lime & Shale		
3271	3335	Lime		
3335	3570	Lime & Shale		
3570	3635	Shale & Sand Strks.		
3635	3995	Lime		
3995	4033	Lime & Shale		
4033	4086	Lime		
4086	4101	Lime - cherty		
4101	4175	Lime		
4175	4221	Shale		
4221	4268	Shale & Lime		
4268	4299	Shale		
4299	4300	Lime - Viola		
4300	4415	Lime		
4415	4480	Sand & Shale		
4480	4520	Lime		
4520		Total Depth.		

I hereby certify that the foregoing is a true and correct copy of the Well Log for the Hartman #1 well drilled for Morrison Drilling Company, Inc. and completed May 5, 1953.

MORRISON DRILLING COMPANY, INC.


 C. W. Wilson - Secretary-Treasurer

STATE OF KANSAS)
) ss.
 COUNTY OF BUTLER)

SUBSCRIBED AND SWORN TO, Before the Undersigned, a Notary Public in and for the County and State aforesaid this 12th day of May, 1953.


 Notary Public

My Commission Expires January 10, 1955.

PLUGGING
 FOR SEC-21-26R-11W
 LOG PAGE 29 LINE 30