

STATE CORPORATION COMMISSION OF KANSAS
OIL & GAS CONSERVATION DIVISION
WELL COMPLETION OR RECOMPLETION FORM
ACO-1 WELL HISTORY
DESCRIPTION OF WELL AND LEASE

Operator: License # 5923
Name AMERICAN PETROLEUM COMPANY, INC.
Address 3500 NORTH ROCK ROAD, BLDG. 1300
City/State/Zip WICHITA, KANSAS 67226

Purchaser NOT APPLICABLE

Operator Contact Person JAMES T. BARVAIS
Phone (316) 636-5273

Contractor: License # 5380
Name EAGLE DRILLING, INC.

Wellsite Geologist BRIAN FISHER & JAMES BARVAIS
Phone (316) 636-5273

Designate Type of Completion

New Well Re-Entry Workover
 Oil SWD Temp Abd
 Gas Inj Delayed Comp.
 Dry Other (Core, Water Supply etc.)

If **OWNO**: old well info as follows:

Operator
Well Name
Comp. Date
Old Total Depth

WELL HISTORY

Drilling Method:

Mud Rotary Air Rotary Cable

5-16-88 5-23-88 5-23-88
Spud Date Date Reached TD Completion Date
4285'
Total Depth PBDT

Amount of Surface Pipe Set and Cemented at 236 feet
Multiple Stage Cementing Collar Used? Yes No
If yes, show depth set.....feet
If alternate 2 completion, cement circulated from.....feet depth to.....w/.....SX cmt
Cement Company Name
Invoice # A I I O & A

API No. 15-151-21,883-00-00
County PRATT
NW SW SW Sec 8 Twp 26 Rge 11 East
X West

* 990
4950 Ft North from Southeast Corner of Section
Ft West from Southeast Corner of Section
(Note: Locate well in section plat below)


Lease Name JORNS Well # 1

Field Name

Producing Formation NOT APPLICABLE

Elevation: Ground 1855 KB 1868

Section Plat

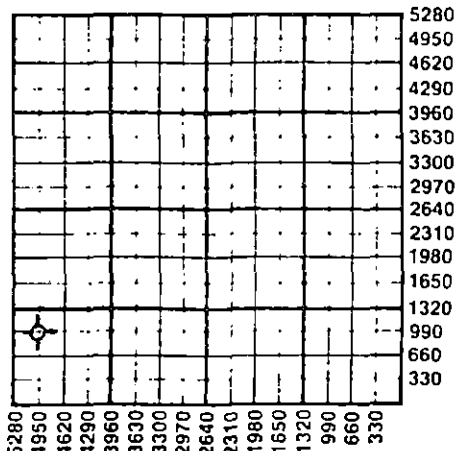

WATER SUPPLY INFORMATION

Disposition of Produced Water: Disposal
Docket # Repressuring

Questions on this portion of the ACO-1 call:

Water Resources Board (913) 296-3717

Source of Water: T 88-253
Division of Water Resources Permit #

Groundwater 330
5050 Ft North from Southeast Corner
(Well) Ft West from Southeast Corner of
Sec 8 Twp 26 Rge 11 East West

Surface Water.....Ft North from Southeast Corner
(Stream, pond etc).....Ft West from Southeast Corner
Sec Twp Rge East West

Other (explain)
(purchased from city, R.W.D. #)

INSTRUCTIONS: This form shall be completed in triplicate and filed with the Kansas Corporation Commission, 200 Colorado Derby Building, Wichita, Kansas 67202, within 120 days of the spud date of any well. Rule 82-3-130, 82-3-107 and 82-3-106 apply.

Information on side two of this form will be held confidential for a period of 12 months if requested in writing and submitted with the form. See rule 82-3-107 for confidentiality in excess of 12 months. One copy of all wireline logs and drillers time log shall be attached with this form. Submit CP-4 form with all plugged wells. Submit CP-111 form with all temporarily abandoned wells.

All requirements of the statutes, rules and regulations promulgated to regulate the oil and gas industry have been fully complied with and the statements herein are complete and correct to the best of my knowledge.

Signature James T. Barvais
JAMES T. BARVAIS
Title President Date 6-10-88

Subscribed and sworn to before me this 10TH day of JUNE 1988
Notary Public Peggy Bennett

Date Commission Expires

PEGGY BENNETT
NOTARY PUBLIC
STATE OF KANSAS
MY APPT. EXPIRES 1-29-89

K.C.C. OFFICE USE ONLY
 Letter of Confidentiality Attached
 Wireline Log Received
 Drillers Timelog Received
Distribution
 KCC SWD/Rep NGPA
 KGS Plug Other
(Specify)
RECEIVED
STATE CORPORATION COMMISSION
JUN 13 1988
Form ACO-1 (5-86)