

15-185-13167-00-00


STATE OF KANSAS
STATE CORPORATION COMMISSION

Form CP-4

Give All Information Completely
Make Required Affidavit
Mail or Deliver Report to:
Conservation Division
State Corporation Commission
212 No. Market
Wichita, Kansas

WELL PLUGGING RECORD

NORTH

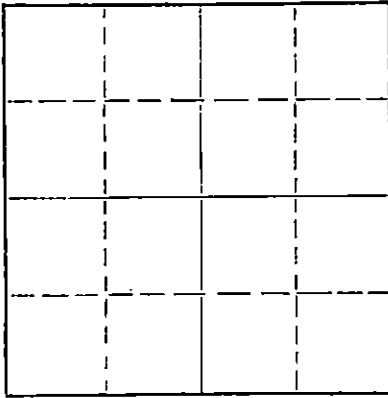Locate well correctly on above
Section Plat

STAFFORD County. Sec. 26 Twp. 22S Rge. 14W (E) (W)
Location as "NE/CNW/SW" or footage from lines. NW NE SE
Lease Owner SANTA-FE PIPE & SUPPLY, INC.
Lease Name SMITH "J" Well No. 3
Office Address BOX 562, GREAT BEND, KANSAS
Character of Well (completed as Oil, Gas or Dry Hole) OIL
Date well completed SEPTEMBER 5 19.56
Application for plugging filed FEBRUARY 8 19.67
Application for plugging approved FEBRUARY 10 19.67
Plugging commenced FEBRUARY 9 19.67
Plugging completed FEBRUARY 15 19.67
Reason for abandonment of well or producing formation DEPLETED

If a producing well is abandoned, date of last production 19.
Was permission obtained from the Conservation Division or its agents before plugging was commenced? YES

Name of Conservation Agent who supervised plugging of this well MR. ARCHIE ELVING
Producing formation Depth to top Bottom Total Depth of Well 3755 Feet
Show depth and thickness of all water, oil and gas formations.

OIL, GAS OR WATER RECORDS

CASING RECORD

FORMATION	CONTENT	FROM	TO	SIZE	PUT IN	PULLED OUT
				8 5/8	301	NONE
				5 1/2	3755	2990

Describe in detail the manner in which the well was plugged, indicating where the mud fluid was placed and the method or methods used in introducing it into the hole. If cement or other plugs were used, state the character of same and depth placed, from feet to feet for each plug set.

3775 - 3692 - PLUG
3692 - 3600 - SAND
3600 - 3540 - 5 SACKS CEMENT
3540 - 280 - MUD
280 - 270 - ROCK BRIDGE
270 - 246 - 8 SACKS CEMENT
246 - 195 - 17 SACKS CEMENT
195 - 40 - MUD
40 - 30 - ROCK BRIDGE
30 - BASE - 10 SACKS CEMENT

Name of Plugging Contractor SANTA-FE PIPE & SUPPLY, INC.
Address BOX 562, GREAT BEND, KANSAS

STATE OF KANSAS, COUNTY OF BARTON, ss.
T.L. NUTT (employee of owner) or (owner or operator) of the above-described well, being first duly sworn on oath, says: That I have knowledge of the facts, statements, and matters herein contained and the log of the above-described well as filed and that the same are true and correct. So help me God.

(Signature)

BOX 562, GREAT BEND, KANSAS
(Address)

Subscribed and Sworn to before me this 7TH day of MARCH, 1967

My commission expires JULY 31, 1970

Notary Public.

WELL LOG
15-185-13167-00-00

COMPANY Petroleum Inc.

SEC. 26 T. 22S R. 14W

FARM Smith

NO. "J" - #3

LOC. NW-NE-SE


TOTAL DEPTH 3836'

COUNTY Stafford Co., Kansas

COMM. 8-26-56

COMP. 9-5-56

CONTRACTOR Garvey Drilling Company

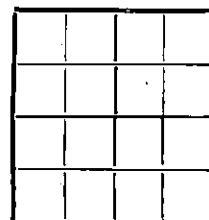

CASING 301' - 8 5/8"
3755' - 5 1/4"

ELEVATION 1925 DF

PRODUCTION Kansas City

FIGURES INDICATE BOTTOM OF FORMATIONS

280' - Sand	Anhydrite - 810
301' - Shale	Heebner - 3307
615' - Red Bed	Brown Lime - 3438
810' - Sand	Lansing - 3450
1400' - Shale	Base KC - 3675
3432' - Lime & Shale	Comglomerate - 3710
3662' - Lime	Viola - 3726
3727' - Lime & Shale	Arbuckle - 3811
3783' - Lime W/Chert	
3816' - Lime & Shale	
3821' - Lime & Chert	
3836' - Lime	

RECORDED
MAR 8 1967
CONSERVATION DISTRICT
Wichita, Kansas

State of Kansas }
County of Barton } ss:

I, Fred Bennett of Garvey Drilling Company

upon oath state that the above and foregoing is a true and correct copy of the log of the #3 Smith "J" well

Fred Bennett

Subscribed and sworn to before me this 21 st. day of September 19 56

My Commission Expires: 11-12-58
Notary Public

Notary Public