


Give All Information Completely  
Make Required Affidavit.  
Mail or Deliver Report to:  
Conservation Division  
State Corporation Commission  
212 No. Market  
Wichita, Kansas

WELL PLUGGING RECORD

Stafford County. Sec. 26 Twp. 22 Rge. (E) 14 (W)

Location as "NE/CNW/SW" or footage from lines NW SE SE  
Lease Owner The Bovaird Supply Company  
Lease Name Maud Well No. 1  
Office Address P.O. Box 2590, Tulsa, Oklahoma  
Character of Well (completed as Oil, Gas or Dry Hole) oil  
Date well completed 19  
Application for plugging filed July 9 1969  
Application for plugging approved 19  
Plugging commenced July 15 1969  
Plugging completed July 26 1969  
Reason for abandonment of well or producing formation depleted

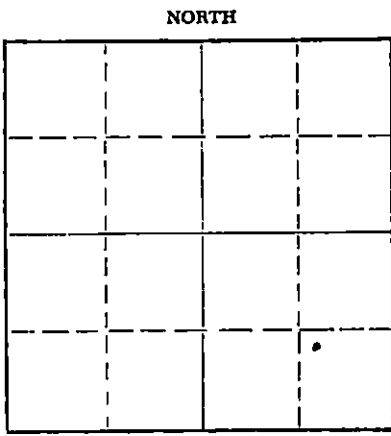

Locate well correctly on above Section Flat

If a producing well is abandoned, date of last production 19  
Was permission obtained from the Conservation Division or its agents before plugging was commenced? yes

Name of Conservation Agent who supervised plugging of this well Ralph Warren  
Producing formation Depth to top Bottom Total Depth of Well 3817 Feet  
Show depth and thickness of all water, oil and gas formations.

OIL, GAS OR WATER RECORDS

CASING RECORD

FORMATION	CONTENT	FROM	TO	SIZE	PUT IN	PULLED OUT
		0	339'	8 5/8"	339'	none
		0	3815'	5 1/2"	3815'	2719.57

Describe in detail the manner in which the well was plugged, indicating where the mud fluid was placed and the method or methods used in introducing it into the hole. If cement or other plugs were used, state the character of same and depth placed, from feet to feet for each plug set.

Sanded back to 3600' and dumped 5 sacks of cement.  
Squeezed well with 15 sacks gel and 75 sacks bulk cement.

RECEIVED  
STATE CORPORATION COMMISSION  
AUG 15 1969  
CONSERVATION DIVISION  
Wichita, Kansas

(If additional description is necessary, use BACK of this sheet)  
Name of Plugging Contractor PIPE PULLERS, INC.  
Address Box 486, Ellinwood, Kansas

STATE OF Kansas, COUNTY OF Barton, ss.  
Evelyn Roth (employee of owner) or (owner-or-operator) of the above-described well, being first duly sworn on oath, says: That I have knowledge of the facts, statements, and matters herein contained and the log of the above-described well as filed and that the same are true and correct. So help me God.

(Signature) Evelyn Roth  
Ellinwood, Kansas  
(Address)

SUBSCRIBED AND SWORN TO before me this 13th day of August, 1969  
George A. Meyer  
Notary Public.

My commission expires Feb. 10, 1971

15-185-13011-00-00  
WELL LOG

COMPANY **Lion Oil Company**

SEC. 26 T. 22 R. 14

FARM **MAUD**

NO. 1

LOC. NW SE SE


TOTAL DEPTH **3817'**

COUNTY **Stafford County, Kans.**

COMM. **February 20, 1954.**

COMP. **March 3, 1954.**

CONTRACTOR **Garvey Drilling Co.**

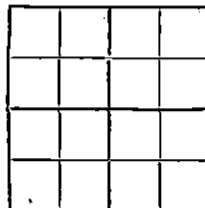

CASING **8-5/8" @ 339' w/300 sax.**  
**5-1/2" @ 3815' w/150 sax.**

ELEVATION **1930' R.S.**

PRODUCTION **Arbuckle**

FIGURES INDICATE BOTTOM OF FORMATIONS

60 Surface Sand  
250 Coarse Sand  
300 Water Sand  
825 Red Bed  
852 Anhydrite  
1675 Shale & Shells  
3450 Lime & Shale  
3670 Lime  
3735 Lime & Shale  
3723 Chert & Shale  
3756 Chert  
3807 Shale  
3809 Lime  
3814 Lime & Shale  
3817 Lime  
  
3817 R.T.D.

RECEIVED  
STATE CORPORATION COMMISSION  
JUL 10 1969  
CONSERVATION DIVISION  
Wichita, Kansas

State of KANSAS }  
County of SEBOWICK } ss:

I, W. W. Fisher of Garvey Drilling Company

upon oath state that the above and foregoing is a true and correct copy of the log of the MAUD #1 well.

W. W. Fisher

Subscribed and sworn to before me this 8th day of March 19 54

My Commission Expires: October 13, 1954.

Charlotta Mesmer  
NOTARY PUBLIC