


Give All Information Completely  
Make Required Affidavit  
Mail or Deliver Report to:  
Conservation Division  
State Corporation Commission  
212 No. Market  
Wichita, Kansas

WELL PLUGGING RECORD

NORTH

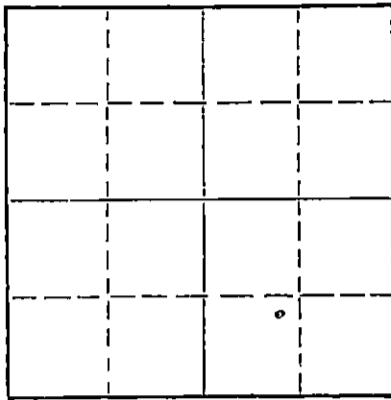

Locate well correctly on above Section Plat

Stafford County. Sec. 26 Twp. 22 Rge. (E) 14 (W)  
Location as "NE/CNW/SE" or footage from lines NE SW SE  
Lease Owner The Bovaird Supply Company  
Lease Name Maud Well No. 2  
Office Address P.O. Box 2590, Tulsa, Oklahoma  
Character of Well (completed as Oil, Gas or Dry Hole) oil  
Date well completed 19  
Application for plugging filed July 14 19 69  
Application for plugging approved 19  
Plugging commenced July 22 19 69  
Plugging completed August 4 19 69  
Reason for abandonment of well or producing formation depleted

If a producing well is abandoned, date of last production 19  
Was permission obtained from the Conservation Division or its agents before plugging was commenced? yes

Name of Conservation Agent who supervised plugging of this well Ralph Warren  
Producing formation Depth to top Bottom Total Depth of Well 3832 Feet  
Show depth and thickness of all water, oil and gas formations.

OIL, GAS OR WATER RECORDS

CASING RECORD

FORMATION	CONTENT	FROM	TO	SIZE	PUT IN	PULLED OUT
		0	357'	8 5/8"	357'	none
		0	3829'	5 1/2"	3829'	1399.95

Describe in detail the manner in which the well was plugged, indicating where the mud fluid was placed and the method or methods used in introducing it into the hole. If cement or other plugs were used, state the character of same and depth placed, from feet to feet for each plug set.

Sanded back to 3600' and dumped 5 sacks of cement.  
Squeezed well with 15 sacks gel and 75 sacks cement.

RECEIVED  
STATE CORPORATION COMMISSION  
AUG 15 1969  
CONSERVATION DIVISION  
Wichita, Kansas

Name of Plugging Contractor PIPE PULLERS, INC.  
Address Box 486, Ellinwood, Kansas

STATE OF Kansas, COUNTY OF Barton, ss.  
Evelyn Roth (employee of owner) or (owner or operator) of the above-described well, being first duly sworn on oath, says: That I have knowledge of the facts, statements, and matters herein contained and the log of the above-described well as filed and that the same are true and correct. So help me God.

(Signature) Evelyn Roth  
Ellinwood, Kansas  
(Address)

SUBSCRIBED AND SWORN TO before me this 14th day of August 19 69

My commission expires Feb. 10, 1971

George A. Meyer  
Notary Public.

15-185-13166-00-00

WELL LOG BUREAU—KANSAS GEOLOGICAL SOCIETY  
508 East Murdock, Wichita, Kansas


COPY

Company: LION OIL COMPANY  
Farm: Maud No. 2

SEC. 26 T. 22 R. 11W  
NE SW SE

Total Depth. 3832  
Comm. 9-16-54 Comp. 9-25-54  
Shot or Treated.  
Contractor. Carey Drlg. Co.  
Issued. 11-27-54

County Stafford  
KANSAS

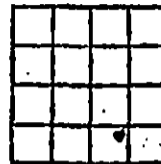

Elevation. 1939

Production. BHB 722 BO & NW

CASING:

8 5/8" 357' cem. w/300 sx  
5 1/2" 3829' cem. w/150 sx

Figures indicate Bottom of Formations.

sand	210
clay, sand & shale	357
redbed	840
Anhydrite	870
redbed, shale & shells	1110
shale & shells	1465
lime & shale	1975
lime	2155
lime & shale	2515
shale & shells	2675
lime & shale	2825
lime, shale & shells	3010
lime	3145
lime & shale	3345
lime	3741
chert	3777
shale	3800
sand & shale	3832
Total depth	

Scout Tops:	
Lansing	3463
Viola	3741
Arbuckle	3828

RECEIVED  
STATE CORPORATION COMMISSION  
JUL 16 1969  
CONSERVATION DIVISION  
Wichita, Kansas