


STATE OF KANSAS
STATE CORPORATION COMMISSION

WELL PLUGGING RECORD

Give All Information Completely
Make Required Affidavit
Mail or Deliver Report to
Conservation Division
State Corporation Comm.
245 North Water
Wichita, KS 67202

Pratt County. Sec. 15 Twp. 26S Rge. 15W E/W
Location as "NE/CNW 1/4 SW 1/4" or footage from lines
440' N C SL, N/2
Lease Owner F. G. Holl
Lease Name Curtis #1-15 Well No. 1
Office Address 6427 East Kellogg, Wichita, Kansas 67207
Character of Well (Completed as Oil, Gas or Dry Hole)

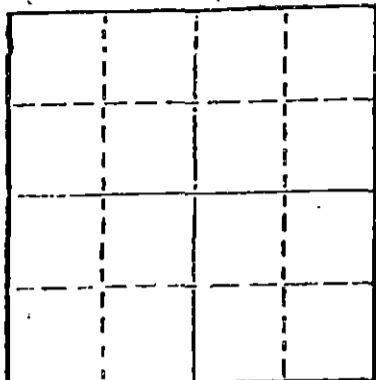

Locate well correctly on above
Section Plot

Dry Hole
Date Well completed September 6, 1978 19
Application for plugging filed September 6, 1978 19
Application for plugging approved September 6, 1978 19
Plugging commenced 9:00 PM - September 6, 1978 19
Plugging completed 11:15 PM - September 6, 1978 19
Reason for abandonment of well or producing formation

Dry Hole
If a producing well is abandoned, date of last production 19

Was permission obtained from the Conservation Division or
its agents before plugging was commenced? Yes

Name of Conservation Agent who supervised plugging of this well Bill Owen
Producing formation Depth to top Bottom Total Depth of Well 4470'
Show depth and thickness of all water, oil and gas formations.

OIL, GAS OR WATER RECORDS

CASING RECORD

FORMATION	CONTENT	FROM	TO	SIZE	PUT IN	PULLED OUT
				8 5/8"	106.5'	None

Describe in detail the manner in which the well was plugged, indicating where the mud fluid
was placed and the method or methods used in introducing it into the hold. If cement or other
plugs were used, state the character of same and depth placed, from feet to
feet for each plug set.

Filled hole with heavy mud.
Pumped through open ended Drill Pipe
50 sacks at 420', solid bridge at
40' with plug and 1/2 sack bulls.
12 sacks to surface and 3 sacks in
rathole. Used 50/50 Pozmix cement.

RECEIVED
STATE CORPORATION COMMISSION
SEP 18 1978
CONSERVATION DIVISION
Wichita, Kansas

(If additional description is necessary, use BACK of this sheet)

Name of Plugging Contractor Sterling Drilling Company
P. O. Box 129, Sterling, Kansas 67579

STATE OF KANSAS COUNTY OF RICE ss.

F. A. Wuellner (employee of owner) or (owner or operator) of the above-described
well, being first duly sworn on oath, says: That I have knowledge of the facts, statements, and matters herein contained and the log of the
above-described well as filed and that the same are true and correct. So help me God. STERLING DRILLING COMPANY

(Signature) F. A. Wuellner, Secretary
P. O. Box 129, Sterling, Kansas 67579
(Address)

Subscribed and Sworn to before me this 7th day of September 19 78



Charles M. Hall, Notary Public.

STERLING DRILLING COMPANY
P. O. Box 129
Sterling, Kansas 67579

WELL LOG ----- CURTIS #1-15
Located: 440' N C SL, N/2, Section 15-26S-15W, Pratt
County, Kansas

OWNER: F. G. Holl
ROTARY DRILLING CONTRACTOR: Sterling Drilling Company

COMMENCED: August 30, 1978
COMPLETED: September 6, 1978

TOTAL DEPTH: 4470'

<u>LOG</u>	<u>CASING RECORD</u>
0 - 325 Sand and Gravel	Ran 9 joints used 28#, 8 5/8" casing, 394.47' set at 406.5' K.B. with 375 sacks Pommix 60/40, with 3% cc. Plug down at 1:45 PM, 8-30-78, by Howco.
325 - 409 Clay and Shale	
409 - 475 Clay and Red Beds	
475 - 841 Shale, Sand and Red Bed	
841 - 934 Sand and Shale	
934 - 1936 Shale	
1936 - 4293 Lime and Shale	
4293 - 4470 Lime, Chert and Shale	Plugged.

RECEIVED
STATE CORPORATION COMMISSION

SEP 18 1978

CONSERVATION DIVISION
Wichita, Kansas