


STATE OF KANSAS
STATE CORPORATION COMMISSION

WELL PLUGGING RECORD

Give All Information Completely
Make Required Affidavit
Mail or Deliver Report to
Conservation Division
State Corporation Comm.
245 North Water
Wichita, KS 67202

Barber County, Sec. 32 Twp. 34S Rge. 14W E/W
Location as "NE/CNW $\frac{1}{4}$ SW $\frac{1}{4}$ " or footage from lines
100' W of C E/2 SW/4

Lease Owner Graham-Michaelis Corporation
Lease Name Farley Well No. 5
Office Address 211 North Broadway, Wichita, Ks. 67202
Character of Well (Completed as Oil, Gas or Dry Hole) D & A

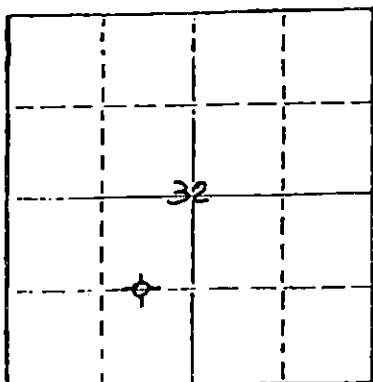

Locate well correctly on above
Section Plat

Date Well completed February 22, 1978
Application for plugging filed February 22, 1978
Application for plugging approved February 22, 1978
Plugging commenced February 22, 1978
Plugging completed February 22, 1978
Reason for abandonment of well or producing formation D & A

If a producing well is abandoned, date of last production 19

Was permission obtained from the Conservation Division or its agents before plugging was commenced? Yes

Name of Conservation Agent who supervised plugging of this well Jasper H. Metz
Producing formation _____ Depth to top _____ Bottom _____ Total Depth of Well 4,855'
Show depth and thickness of all water, oil and gas formations.

OIL, GAS OR WATER RECORDS

CASING RECORD

FORMATION	CONTENT	FROM	TO	SIZE	PUT IN	PULLED OUT
				8 5/8"	887.26'	-0-

Describe in detail the manner in which the well was plugged, indicating where the mud fluid was placed and the method or methods used in introducing it into the hold. If cement or other plugs were used, state the character of same and depth placed, from _____ feet to _____ feet for each plug set.

Plugged hole
Mud to 900' w/45 sx cement
Mud to 40' w/hulls, plug & 12 sx cement
3 sx cement in rathole

RECEIVED
STATE CORPORATION COMMISSION
MAR 01 1978
3-1-78
CONSERVATION DIVISION
Wichita, Kansas

(If additional description is necessary, use BACK of this sheet)

Name of Plugging Contractor Red Tiger Drilling Company
1720 KSB&T Building, Wichita, Kansas 67202

STATE OF Kansas COUNTY OF Sedgwick, ss. contractor,
Gloria Fawcett (employee of ~~xxxxxxx~~)


of the above-described well, being first duly sworn on oath, says: That I have knowledge of the facts, statements, and matters herein contained and the log of the above-described well as filed and that the same are true and correct. So help me God.

(Signature) Gloria Fawcett
1720 KSB&T Building, Wichita, Kansas 67202
(Address)

SUBSCRIBED AND SWORN TO before me this 27th day of February, 1978.

Joyce A. Hagermann
Notary Public.

My commission expires _____

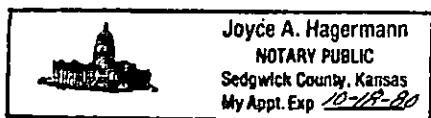

DRILLERS LOG

No. 5 Farley

CASING RECORD:	COMPANY: Graham-Michaelis Corporation	DESCRIPTION:
8 5/8" @ 894' w/475 sx cement	CONTRACTOR: Red Tiger Drilling Company	100' W of C E/2 SW/4 Sec. 32-T34S-R14W Barber County, Kansas
	COMMENCED: February 11, 1978	
	COMPLETED: February 22, 1978	
TOTAL DEPTH: 4,855'		ELEVATION: 1,506' KB

<u>FORMATION</u>	<u>FROM</u>	<u>TO</u>	<u>REMARKS</u>
Surface Soil	0	223	
Red Bed	223	297	
Red Bed & Sand Streaks	297	314	
Red Bed	314	374	
Red Bed & Sand Streaks	374	630	
Red Bed	630	1407	
Shale & Red Bed	1407	1529	
Anhydrite/Shale	1529	1546	
Shale/Lime	1546	1721	
Shale	1721	1765	
Lime	1765	2835	
Lime & Shale	2835	3312	
Lime	3312	3480	
Lime & Shale	3480	3928	
Lime	3928	4800	
Chert & Lime	4800	4855	
RTD		4855	

RECEIVED
STATE CORPORATION COMMISSION

MAR 01 1978
3-1-78
CONSERVATION DIVISION
Wichita, Kansas

I certify that this is a true and correct copy of the above log to the best of my knowledge.

RED TIGER DRILLING COMPANY

Gloria Fawcett
Gloria Fawcett

Subscribed and sworn to before me this 27th day of February, 1978.

Joyce A. Hagermann
Notary Public

