


STATE OF KANSAS  
STATE CORPORATION COMMISSION

WELL PLUGGING RECORD

Give All Information Completely  
Make Required Affidavit  
Mail or Deliver Report to:  
Conservation Division  
State Corporation Commission  
800 Bitting Building  
Wichita, Kansas

Pratt County. Sec. 16 Twp. 27 Rge. (E) 11 (W)

NORTH

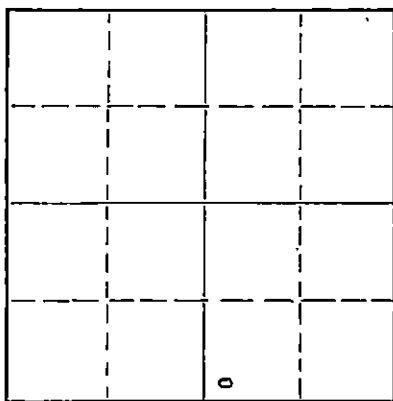

Locate well correctly on above  
Section Plat

Location as "NE/CNW&SW" or footage from lines SW SW SE  
Lease Owner Graham-Messman-Rinehart Oil Company  
Lease Name Bradley Well No. 1  
Office Address 1005 East Second, Wichita, Kansas  
Character of Well (completed as Oil, Gas or Dry Hole) Dry Hole  
Date well completed Nov. 14, 1954 19  
Application for plugging filed Nov. 14, 1954 (verbal) 19  
Application for plugging approved Nov. 14, 1954 (verbal) 19  
Plugging commenced Nov. 15, 1954 19  
Plugging completed Nov. 15, 1954 19  
Reason for abandonment of well or producing formation Dry hole

If a producing well is abandoned, date of last production \_\_\_\_\_ 19  
Was permission obtained from the Conservation Division or its agents before plugging was commenced? Yes

Name of Conservation Agent who supervised plugging of this well Warren H. Horner, Great Bend, Kansas  
Producing formation \_\_\_\_\_ Depth to top \_\_\_\_\_ Bottom \_\_\_\_\_ Total Depth of Well 4560 Feet  
Show depth and thickness of all water, oil and gas formations.

OIL, GAS OR WATER RECORDS

CASING RECORD

FORMATION	CONTENT	FROM	TO	SIZE	PUT IN	PULLED OUT
				13 3/8	220	None
				8 5/8	680	555

Describe in detail the manner in which the well was plugged, indicating where the mud fluid was placed and the method or methods used in introducing it into the hole. If cement or other plugs were used, state the character of same and depth placed, from \_\_\_\_\_ feet to \_\_\_\_\_ feet for each plug set.

Plugged hole at 220 feet with  
1/2 sack hulls and 20 sacks  
cement. Top plug at 35 feet  
with 1/2 sack hulls and 10 sacks  
cement.

(If additional description is necessary, use BACK of this sheet)

Name of Plugging Contractor Graham-Messman-Rinehart Drilling Company (License No. 20)  
Address 1005 East Second, Wichita, Kansas

STATE OF Kansas, COUNTY OF Sedgwick, ss.  
J. A. Gilliland (employee of owner or contractor) of the above-described well, being first duly sworn on oath, says: That I have knowledge of the facts, statements, and matters herein contained and the log of the above-described well as filed and that the same are true and correct. So help me God.

(Signature) J. A. Gilliland  
1005 East Second, Wichita, Kansas  
(Address)

SUBSCRIBED AND SWORN TO before me this 22nd day of November, 19 54

Barbara J. Scott  
Notary Public.

My commission expires December 1, 1956

PLUGGING  
FILE SEC 16 T 27 R 11 W  
BOOK PAGE 29 LINE 9

NO. 1 BRADLEY

WELL RECORD

Location: SW SW SE, 16-27S-11W  
Pratt County, Kansas

Commenced: October 31, 1954

Operator: Graham-Messman-Rinehart Oil Company  
1005 East Second, Wichita, Kansas

Completed: November 14, 1954

Elevation: 1820 KB

Contractor: Graham-Messman-Rinehart Drilling Co.  
1005 East Second, Wichita, Kansas

Productions: D&A

Casing Records: 13 3/8" @ 220' w/250 sacks cement  
8 5/8" @ 680' w/50 sacks cement

.....L O G.....

Sand	189
Red bed	222
Sand-shale	662
Lime-shale	1181
Shale-lime	1890
Lime-shale	3715
Lime	3804
Lime-shale	3840
Lime	3905
Lime-shale	3948
Lime	4005
Lime-shale	4067
Lime	4133
Chert-lime	4165
Lime	4214
Shale-lime	4253
Lime-shale	4334
Lime	4375
Lime-chert	4446
Lime-chert-sand	4478
Lime-shale	4536
Lime	4560 R.T.D.

Heebner 3460 (-1640)
Douglas Sandy Shale 3486 (-1666)
Brown Lime 3637 (-1817)
Lansing 3656 (-1836)
Mississippi 4106 (-2286)
Kinderhook 4213 (-2393)
Viola 4342 (-2522)
Simpson 4438 (-2618)
Arbuckle 4520 (-2700)

The undersigned, GRAHAM-MESSMAN-RINEHART DRILLING COMPANY, hereby certifies that the above log is a true and correct log of the formation encountered in drilling the above well as reflected by the Daily Drilling Report.

GRAHAM-MESSMAN-RINEHART DRILLING COMPANY

By:

J. A. Gilliland  
J. A. Gilliland

Subscribed and sworn to before me this  
22nd day of November, 1954

Barbara J. Scott  
Notary Public

My Commission Expires: December 1, 1956

PLUGGING  
FILE SEC 16 T 27 R 11W  
BOOK PAGE 29 LINE 2