


15-033-00101-0000

STATE OF KANSAS
STATE CORPORATION COMMISSION

Give All Information Completely
Make Required Affidavit
Mail or Deliver Report to:
Conservation Division
State Corporation Commission
800 Bittling Building
Wichita, Kansas

WELL PLUGGING RECORD

NORTH

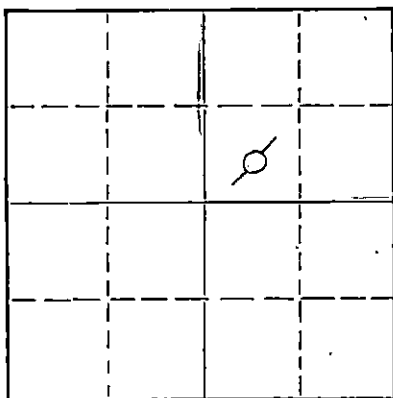

Locate well correctly on above
Section Plat

Commanche County. Sec. 4 Twp. 35S Rge. 19W ~~19E~~ (W)
Location as "NE/CNW/SW" or footage from lines G SW/4 of NE/4
Lease Owner J. M. Huber Corp.
Lease Name Patterson Well No. 1
Office Address Box 978, Liberal, Kansas
Character of Well (completed as Oil, Gas or Dry Hole) Dry Hole
Date well completed 8-7-55 19
Application for plugging filed 8-7-55 19
Application for plugging approved 8-7-55 19
Plugging commenced 8-7-55 19
Plugging completed 8-7-55 19
Reason for abandonment of well or producing formation Dry Hole

If a producing well is abandoned, date of last production 19
Was permission obtained from the Conservation Division or its agents before plugging was commenced? YES

Name of Conservation Agent who supervised plugging of this well M. A. Rives
Producing formation _____ Depth to top _____ Bottom _____ Total Depth of Well 5453' Feet
Show depth and thickness of all water, oil and gas formations.

OIL, GAS OR WATER RECORDS

CASING RECORD

| FORMATION | CONTENT | FROM | TO | SIZE | PUT IN | PULLED OUT |
|-----------|---------|------|----|---------|--------|------------|
| | | | | 13-3/8" | 167 | None |
| | | | | 8-5/8" | 610 | None |
| | | | | | | |
| | | | | | | |
| | | | | | | |
| | | | | | | |

Describe in detail the manner in which the well was plugged, indicating where the mud fluid was placed and the method or methods used in introducing it into the hole. If cement or other plugs were used, state the character of same and depth placed, from _____ feet to _____ feet for each plug set.

Filled hole with mud. Pushed Halliburton plug to 600' with drill pipe.

Spotted 35 sacks at 590' thru pipe. Halliburton plug at 35'. Filled to surface with 15 sacks.

RECEIVED
STATE CORPORATION COMMISSION

23-55
CONSERVATION DIVISION

Name of Plugging Contractor George Drilling Inc.
Address 505 Petroleum Bldg., Wichita, Kansas

STATE OF KANSAS, COUNTY OF SEWARD, ss.
W. W. HENSON (employee of owner) or (owner/operator) of the above-described

well, being first duly sworn on oath, says: That I have knowledge of the facts, statements, and matters herein contained and the log of the above-described well as filed and that the same are true and correct. So help me God.

(Signature) *W. W. Henson*
Box 978, Liberal, Kansas
(Address)

SUBSCRIBED AND SWORN to before me this 22 day of August, 19 55

My commission expires 7-27-57

J. R. Kypker
Notary Public.

PLUGGING
FILE SEC 4 T 35 R 19 W
BOOK PAGE 141 LINK 20

WELL LOGWELL NAME: Patterson #1WELL LOCATION: Center SW/4 of NE/4 of Section 4, Township 35S, Range 19W,
Commanche Co., Kansas.WELL OWNER: J. M. Huber Corp.DRILLING COMMENCED: 7-9-55DRILLING COMPLETED: 8-7-55WELL COMPLETED: 8-7-55Total Depth: 5453'FORMATIONDEPTH

| | |
|--------------------------|-------------|
| Soil and red clay | 0 - 70 |
| Shells | 70 - 80 |
| Lime and redbed | 80 - 170 |
| Shale, redbed and sand | 170 - 225 |
| ? | 225 - 260 |
| Sand and redbed | 260 - 348 |
| Redbed, shale and shells | 348 - 505 |
| Shale and shells | 505 - 610 |
| Redbed | 610 - 632 |
| Redbed, shale and shells | 632 - 1070 |
| Shale and shells | 1070 - 1710 |
| Lime streaks | 1710 - 1720 |
| Shale and shells | 1720 - 1950 |
| Shale and lime | 1950 - 2190 |
| Lime | 2190 - 2304 |
| Lime and shale | 2304 - 2455 |
| Lime | 2455 - 2530 |
| Lime and shale | 2530 - 2805 |
| Lime | 2805 - 2930 |
| Sandy shale | 2930 - 2955 |
| Lime and shale-sandy | 2955 - 3030 |
| Shale and lime | 3030 - 3052 |
| Sandy shale | 3052 - 3080 |
| Chalky lime and shale | 3083 - 3141 |
| Lime and shale | 3141 - 3400 |
| Chalky lime | 3400 - 3490 |
| Lime | 3490 - 3775 |
| Lime and chert | 3775 - 3790 |
| Lime | 3790 - 3820 |
| Shale | 3820 - 3860 |
| Shale and lime | 3860 - 4015 |
| Lime and shale -sandy | 4015 - 4107 |
| Shale-sandy | 4107 - 4185 |
| Shale and lime | 4185 - 4220 |
| Shale and lime-sandy | 4220 - 4314 |

RECEIVED
 THE CORPORATION COMMISSION
 8-23-55
 CONSERVATION DIVISION
 MONTICELLO, KANSAS

PLUGGING
 TWP SEC 4 T35 R 19W
 BOOK PAGE 141 LINE 30

WELL LOG--Patterson #1
Page 2

| <u>FORMATION</u> | <u>DEPTH</u> |
|----------------------|--------------|
| Lime | 4314 - 4415 |
| Lime and sand | 4415 - 4485 |
| Lime | 4485 - 4768 |
| Lime and shale | 4768 - 4794 |
| Big lime | 4794 - 4820 |
| Lime | 4820 - 4870 |
| Shale and lime | 4870 - 5101 |
| Lime and shale-sandy | 5101 - 5128 |
| Lime and shale | 5128 - 5232 |
| Lime | 5232 - 5247 |
| Lime and shale | 5247 - 5306 |
| Sandy shale | 5306 - 5321 |
| Lime | 5321 - 5328 |
| Lime-cherty | 5328 - 5348 |
| Lime and chert | 5348 - 5351 |
| Lime-cherty | 5351 - 5378 |
| Lime | 5378 - 5410 |
| Lime-cherty | 5410 - 5436 |
| Lime | 5436 - 5453 |
| Total Depth | 5453 |

STATE OF KANSAS, COUNTY OF SEWARD, ss:

W. W. Henson, employee of owner of the above-described well, being first duly sworn on oath, says: That I have knowledge of facts, statements and matters herein contained and the log of the above-described well as filed and that the same are true and correct.

W. W. Henson

Subscribed and sworn to before me this 22 day of August, 1955.

J. R. Kessler
 Notary Public

My commission expires:

7-27-57