


15-033-30067-0000

Give All Information Completely  
Make Required Affidavit  
Mail or Deliver Report for  
Conservation Division  
State Corporation Commission  
211 No. Broadway  
Wichita, Kansas

WELL PLUGGING RECORD

NORTH

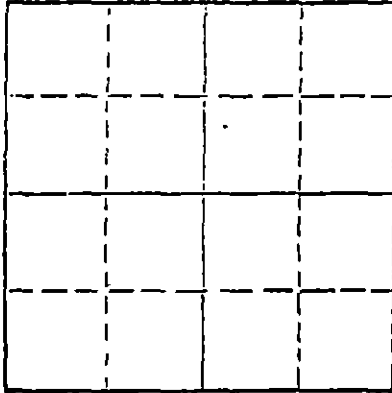

Locate well correctly on above  
Section Plot

Comanche County. Sec. 8 Twp 35S Rge. (E) 16 (W)  
Location as "NE/CNWxSWx" or footage from lines C NW NW  
Lease Owner Anadarko Production Company  
Lease Name McMoran "A" Well No. 1  
Office Address P. O. Box 351 Liberal, Kansas  
Character of Well (completed as Oil, Gas or Dry Hole) Dry Hole  
Date well completed 4-20 19 66  
Application for plugging filed 5-23 19 66  
Application for plugging approved 5-24 19 66  
Plugging commenced 5-24 19 66  
Plugging completed 5-27 19 66  
Reason for abandonment of well or producing formation Non-economical

If a producing well is abandoned, date of last production 19  
Was permission obtained from the Conservation Division or its agents before plugging was commenced? Yes

Name of Conservation Agent who supervised plugging of this well Archie V. Elving Box 248 Pratt, Kansas  
Producing formation \_\_\_\_\_ Depth to top \_\_\_\_\_ Bottom \_\_\_\_\_ Total Depth of Well 6282 Feet  
Show depth and thickness of all water, oil and gas formations.

OIL, GAS OR WATER RECORDS

CASING RECORD

FORMATION	CONTENT	FROM	TO	SIZE	PUT IN	PULLED OUT
				13-3/8"	310'	None
				5-1/2"	5500'	4222'

Describe in detail the manner in which the well was plugged, indicating where the mud fluid was placed and the method or methods used in introducing it into the hole. If cement or other plugs were used, state the character of same and depth placed, from \_\_\_\_\_ feet to \_\_\_\_\_ feet for each plug set.  
Mixed 20 sacks of cement. Pumped plug to 4750' with mud.  
Shot off 5-1/2" casing at 4222'. Pulled casing to 550'.  
Spotted heavy mud. Pulled casing to 310'. Spotted 50 sacks of cement at 310'.  
Displaced with mud. Finished pulling casing. Filled hole with mud to 30'.  
Spotted 20 sacks of cement from 30' to surface.  
Top of 13-3/8" casing capped w/steel plate.  
Completed at 12 Noon 5/27/66.

RECEIVED  
STATE CORPORATION COMMISSION

JUN 7 1966  
6-7-66  
CONSERVATION DIVISION  
Wichita, Kansas

(If additional description is necessary, use BACK of this sheet)  
Name of Plugging Contractor Sargent's Casing Pulling Service.  
Address 1546 Clay Courts Liberal, Kansas.

STATE OF Kansas COUNTY OF Seward ss.  
V. K. Downey (employee of owner) or (owner or operator) of the above-described well, being first duly sworn on oath, says: That I have knowledge of the facts, statements, and matters herein contained and the log of the above-described well as filed and that the same are true and correct. So help me God.

(Signature) V. K. Downey  
P. O. Box 351 Liberal, Kansas  
(Address)

SUBSCRIBED AND SWORN TO before me this 8th day of June 19 66  
Donald L. Vangieson  
Notary Public.

My commission expires \_\_\_\_\_  
My Commission Expires Sept. 29, 1968

Donald L. Vangieson

15-033-30067-0000

DRILLER'S LOG

WELL NAME: McMoran "A" No. 1 ; COMPANY OPERATING: Anadarko Production Company  
 ADDRESS of COMPANY: Box 351 Liberal, Kansas

WELL LOCATION: C 1/4 NW 1/4 NW 1/4,  
4620 ft. North of South line,  
667 ft. East of West line; Sec. 8, Twp. 35S, Rge. 16W, Comanche County, Kansas

DRILLING STARTED 3-6, 1966; DRILLING COMPLETED 3-31, 1966  
 WELL COMPLETED 4-20, 1966; WELL CONNECTED \_\_\_\_\_, 19\_\_\_\_

ELEVATION: 2971.70 ft. Ground Level; CHARACTER OF WELL (Oil, Gas, or Dry Hole) Dry Hole

OIL OR GAS SANDS OR ZONES - PERFORATIONS - ACIDIZING AND FRACTURING INFORMATION					
Name	From	To	No. of Shots	Gallons Used	Kind Used
Mississippian	5371	5405	32	1,000	15% N.E.
Mississippian	5282	5311	34	5,000	15% Retarded
				30,000	5% Acid
Marmaton	5005	5009	8	500	15% N.E.
Marmaton	4982	4990	36	1,000	15% N.E.

CASING RECORD

Size	Amount Set	Sacks of Cement	Amount Pulled
13-3/8"	310'	400	None
5-1/2"	5500'	170	4222'
2-3/8"	5296'		5296'

FORMATION RECORD

Formation	Top	Bottom	Formation	Top	Bottom
Red Bed	0	150	Lime & Shale	5725	5800
Shale	150	360	Lime	5800	6282
Red Bed & Shale	360	625	TOTAL DEPTH		6282
Red Bed & Shale	625	1540			
Shale & Shells	1540	2370			
Lime & Shale	2370	4640			
Lime	4640	4720			
Lime & Shale	4720	4768			
Lime	4768	5320			
Lime & Chert	5320	5410			
Lime	5410	5565			
Lime & Chert	5565	5654			
Lime	5654	5725			

1537  
 APR 11 1966  
 4617 7 A 1966  
 6-11-66  
 WINDING DIVISION  
 Liberal, Kansas

RESULTS of INITIAL PRODUCTION TEST: Plugged & abandoned on May 27, 1966.