

15-151-20100-0000


STATE OF KANSAS
STATE CORPORATION COMMISSION

Form CP-4

Give All Information Completely
Make Required Affidavit
Mail or Deliver Report to:
Conservation Division
State Corporation Commission
212 No. Market
Wichita, Kansas

WELL PLUGGING RECORD

NORTH

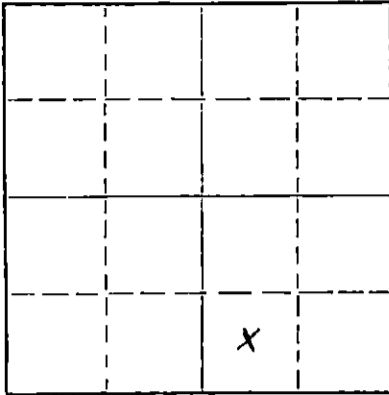

Locate well correctly on above
Section Plat

Pratt County. Sec. 1 Twp. 26S Rge. (E) 12 (W)
Location as "NE/CNW/SW" or footage from lines 150' E of SW SE
Lease Owner Leben Drilling Co.
Lease Name Hoskinson Well No. 2
Office Address P.O. Box 486, Great Bend, Kansas
Character of Well (completed as Oil, Gas or Dry Hole) Dry hole
Date well completed December 3 1968
Application for plugging filed December 5 1968
Application for plugging approved _____ 19____
Plugging commenced December 3 1968
Plugging completed Same 19____
Reason for abandonment of well or producing formation Dry Hole

If a producing well is abandoned, date of last production _____ 19____
Was permission obtained from the Conservation Division or its agents before plugging was commenced? yes

Name of Conservation Agent who supervised plugging of this well Ralph J. Warren
Producing formation _____ Depth to top _____ Bottom _____ Total Depth of Well 4187 Feet
Show depth and thickness of all water, oil and gas formations.

OIL, GAS OR WATER RECORDS

CASING RECORD

FORMATION	CONTENT	FROM	TO	SIZE	PUT IN	PULLED OUT

Describe in detail the manner in which the well was plugged, indicating where the mud fluid was placed and the method or methods used in introducing it into the hole. If cement or other plugs were used, state the character of same and depth placed, from _____ feet to _____ feet for each plug set.

Wood plug pushed to 600' and 50 sacks cement through drill pipe.
Mud to 300' and 25 sacks cement.
Mud to 40', wood plug and 10 sacks cement to surface.
2 sacks cement in rat hole.

RECEIVED
STATE CORPORATION COMMISSION
12-6-68
DEC 6 1968
CONSERVATION DIVISION
Wichita, Kansas


(If additional description is necessary, use BACK of this sheet)

Name of Plugging Contractor Aspen Drilling Co.
Address P.O. Box 783, Great Bend, Kansas

STATE OF Kansas, COUNTY OF Barton, ss.
William S. Schachle (employee of owner) or (owner or operator) of the above-described well, being first duly sworn on oath, says: That I have knowledge of the facts, statements, and matters herein contained and the log of the above-described well as filed and that the same are true and correct. So help me God.

(Signature) William S. Schachle
William S. Schachle
P.O. Box 783, Great Bend, Kansas
(Address)

Subscribed and sworn to before me this 5th day of December, 1968

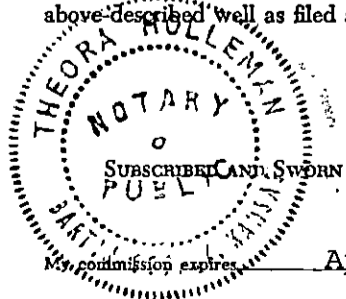

Theora Holliman
Theora Holliman
Notary Public.

My commission expires April 18, 1972

RECEIVED
STATE CORPORATION COMMISSION
12-10-68
DEC 6 1968
CONSERVATION DIVISION
Wichita, Kansas

DRILLERS LOG

COMPANY: Leben Drilling Co.
CONTRACTOR: Aspen Drilling Co.
LEASE NAME: Hoskinson #2
LOCATION: 150' East of SW SE
Sec. 1-T26S-R12W
Pratt County, Kansas
ELEVATION: 1868' KB
SURFACE CASING: 9 jts.(224') 13 3/8"
24 jts.(877') 8 5/8"
COMMENCED: November 22, 1968
COMPLETED: December 3, 1968
ROTARY TOTAL DEPTH: 4187'

<u>FORMATION</u>	<u>DEPTH</u>	
Clay, Sand & Shale	222	Ran 9 jts.(224') 13 3/8" casing
Red Bed	500	set at 220', cemented with 250
Shale	856	sacks. Cement circulated.
Anhydrite	875	Ran 24 jts.(877') 8 5/8" casing
Shale	1705	set at 875', cemented with 250
Shale-Lime	1815	sacks. Cement circulated.
Lime-Shale	2155	
Shale-Lime	2735	DST #1 4006-4030'
Shale	2891	DST #2 4151-4158'
Shale-Lime	3385	DST #3 Mississippi Straddle
Lime-Shale	3742	DST #4 4152-4187'
Lime	3857	
Lime-Shale	3938	Ran electric log.
Lime	4069	
Miss. Chert	4080	
Lime-Chert	4130	
Lime-Shale-Chert	4158	
Viola	4187	
RTD	4187	

AFFIDAVIT

State of Kansas)
) ss:
County of Barton)

The undersigned, being duly sworn on oath, states that the above statement and log are a true and correct record and log of the well drilled at the location above described.

William S. Schachle
William S. Schachle

Subscribed and sworn to before me this 5th day of December, 1968.

Theora Holleman
Theora Holleman, Notary Public

My commission expires: April 18, 1972

Hoskinson #2
150' E. of SW SE
Sec. 1-T26S-R12W
Pratt County, Kansas

RECEIVED
STATE CORPORATION COMMISSION
12-6-68
DEC 6 1968
CONSERVATION DIVISION
Wichita, Kansas

Spudded 12 $\frac{1}{4}$ " hole and drilled to 222'.

Went in with 17 $\frac{1}{4}$ " reamer and reamed to bottom.

Set 13 3/8" surface casing at 220', cemented with 250 sacks Sunset.
Cement circulated.

Started drilling with 7 7/8" hole, lost circulation at 529'.

Reamed 7 7/8" hole with 12 $\frac{1}{4}$ " bit to 529'.

Drilled 12 $\frac{1}{4}$ " hole from 529' to 877'.

Set 877' of 8 5/8" casing at 875', cemented with 250 sacks Sunset.
Cement circulated.