

15-151-00357-0000

STATE OF KANSAS  
STATE CORPORATION COMMISSION

WELL PLUGGING RECORD

Give All Information Completely  
Make Required Affidavit  
Mail or Deliver Report to:  
Conservation Division  
State Corporation Commission  
800 Bitting Building  
Wichita, Kansas

Pratt County, Sec. 4 Twp. 26 Rge. 12 (W)

Location as "NE/CNW/SW" or footage from lines NE NW SE

Lease Owner Goppinger Drilling, Inc.

Lease Name Snyder Well No. 1

Office Address 320 Union Natl Bk Bldg., Wichita

Character of Well (completed as Oil, Gas or Dry Hole) dry hole

Date well completed Sept. 14 19 55

Application for plugging filed Sept. 14 19 55

Application for plugging approved same 19


Plugging commenced same 19

Plugging completed same 19

Reason for abandonment of well or producing formation

If a producing well is abandoned, date of last production 19

Was permission obtained from the Conservation Division or its agents before plugging was commenced? yes

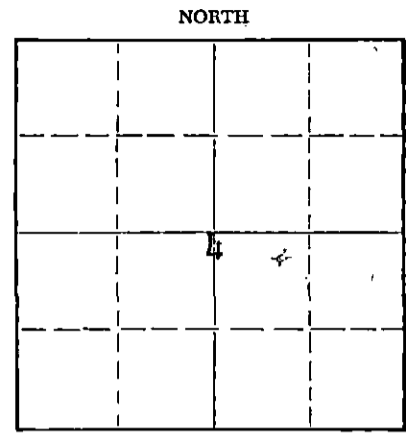

Locate well correctly on above Section Plat

Name of Conservation Agent who supervised plugging of this well Merle Rives - Pratt, Ks.

Producing formation Depth to top Bottom Total Depth of Well 4307 Feet

Show depth and thickness of all water, oil and gas formations.

OIL, GAS OR WATER RECORDS

CASING RECORD

FORMATION	CONTENT	FROM	TO	SIZE	PUT IN	PULLED OUT
				8-5/8"	326	---

Describe in detail the manner in which the well was plugged, indicating where the mud fluid was placed and the method or methods used in introducing it into the hole. If cement or other plugs were used, state the character of same and depth placed, from feet to feet for each plug set.

Filled hole with mud laden fluid to 300' of top.  
Pushed plug to 300'.  
Cemented with 20 sax.  
Filled hole to 40' of top;  
pushed plug to 40'  
Cemented with 15 sax, and capped.

(If additional description is necessary, use BACK of this sheet)

Name of Plugging Contractor Goppinger Drilling, Inc

Address Wichita, Kansas

STATE OF Kansas COUNTY OF Sedgwick ss.  
Lee Poulsen (employee of owner)

being first duly sworn on oath, says: That I have knowledge of the facts, statements, and matters herein contained and the log of the above-described well as filed and that the same are true and correct. So help me God.

(Signature) Lee Poulsen

320 Union Natl Bk Bldg. Wichita (Address)

SUBSCRIBED AND SWORN to before me this 15th day of Sept 19 55

(Mayree Broaddus) Notary Public.

My commission expires March 7, 1956

PLUGGING  
FILE SEC 4 T26 R2W  
BOOK PAGE 150 LINE 13

RECEIVED  
STATE CORPORATION COMMISSION  
SEP 15 1955  
9-16-55  
CONSERVATION DIVISION  
Wichita, Kansas

15-151-00357-0000

OIL PRODUCER

DRILLING CONTRACTOR

# COPPINGER DRILLING, INC.

320 UNION NATIONAL BANK BUILDING

WICHITA 2, KANSAS

## DRILLERS LOG

Contractor: Coppinger Drilling, Inc.  
Drilling commenced: August 27, 1955  
Drilling completed: September 14, 1955

Snyder #1 - NE NW SE  
Section 4-26S-12W  
Pratt County, Kansas

Elevation: 1880' R.B.  
1878' D.F.  
1876' G.L.

Sand	200
Red bed and sand	290
Red bed and shale	326
Red bed and shale	590
Red bed	660
Anhydrite	680
Shale and shells	1185
Salt and shale	1250
Shale and shells	1470
Lime and shale	2825
Shale	2850
Lime	2920
Lime and shale	3275
Lime	3450
Lime and shale	3470
Shale and sand	3552
Shale	3610
Lime and shale	3680
Lime	3730
Lime and shale	3780
Lime	3860
Lime and shale	3910
Lime	3985
Lime and shale	4049
Cherty lime & shale	4065
Lime	4090
Shale	4100
Chert	4138
Lime and shale	4150
Cherty lime and shale	4210
Shale and sand	4255
Lime and shale	4285
Lime	4307

Casing Record: 8-5/8" at 326 w/175 sax posmix

<u>Tops:</u>	<u>Sample</u>	<u>Halliburton</u>
Heebner	3436	3436
Toronto	3453	3448
Douglas	3469	3468
Brown Lime	3612	3612
Lansing	3635	3635
Base Kansas City	3950	3950
Marmaton	3966	3966
Mississippi (Congl. CH?)	4049	4047
Kinderhook	4065	4062
Viola *	4100	4118
Simpson *	4180	4198
Arbuckle	4282	4288
R T D	4307	

\*Viola and Simpson tops have been re-correlated and the Halliburton log tops correspond with the more commonly called tops in this area and are thought to be correct.

Dry and Abandoned.

R T D

4307

RECEIVED  
STATE CORPORATION COMMISSION  
9-16-55  
SEP 16 1955

CONSERVATION DIVISION  
Wichita, Kansas

**PLUGGING**  
STATE OF KANSAS, County of Sedgwick, ss.  
ALL SEC 4 T26 R12W  
BOOK 150 PAGE 23

I hereby certify that the above information is true and correct to the best of my knowledge.

Lee Poulsen  
Lee Poulsen

Mayree Broadus  
(Mayree Broadus) Notary Public

Subscribed and sworn to before me this 15th day of ~~Aug~~ September 1955.  
My commission expires: March 7, 1956