

STATE OF KANSAS
STATE CORPORATION COMMISSION

WELL PLUGGING RECORD

Give All Information Completely
Make Required Affidavit
Mail or Deliver Report to:
Conservation Division
State Corporation Commission
800 Bittling Building
Wichita, Kansas

Pratt County, Sec. 5 Twp. 26S Rge. 12(W)

Location as "NE/CNW/SW" or footage from lines 3630' from S Line, 2310' from W.

Lease Owner Lion Oil Company

Lease Name Holland "B" Well No. 1

Office Address P. O. Box 639, Pratt, Kansas

Character of Well (completed as Oil, Gas or Dry Hole) Dry Hole

Date well completed 12-13 19 53

Application for plugging filed 12-13 19 53

Application for plugging approved 12-13 19 53


Plugging commenced 12-13 19 53

Plugging completed 12-13 19 53

Reason for abandonment of well or producing formation Dry Hole

If a producing well is abandoned, date of last production 19

Was permission obtained from the Conservation Division or its agents before plugging was commenced? Yes

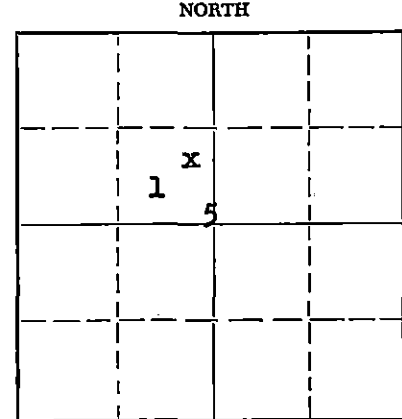

Locate well correctly on above Section Plat

Name of Conservation Agent who supervised plugging of this well Mr. M. A. Rives

Producing formation Depth to top Bottom Total Depth of Well 4330 Feet

Show depth and thickness of all water, oil and gas formations.

OIL, GAS OR WATER RECORDS

CASING RECORD

FORMATION	CONTENT	FROM	TO	SIZE	PUT IN	PULLED OUT
				8-5/8"	286'	0

Describe in detail the manner in which the well was plugged, indicating where the mud fluid was placed and the method or methods used in introducing it into the hole. If cement or other plugs were used, state the character of same and depth placed, from feet to feet for each plug set.

Set bottom plug at 270' with 20 sacks cement.
Set top plug at 40' with 10 sacks cement.

(If additional description is necessary, use BACK of this sheet)

Name of Plugging Contractor Musgrove Petroleum Corporation
Address 518 Petroleum Bldg., Wichita, Kansas

STATE OF KANSAS, COUNTY OF PRATT, ss.
Vernon Hayes (employee of owner)


well, being first duly sworn on oath, says: That I have knowledge of the facts, statements, and matters herein contained and the log of the above-described well as filed and that the same are true and correct. So help me God.

(Signature) Vernon Hayes
P. O. Box 639, Pratt, Kansas
(Address)

SUBSCRIBED AND SWORN TO before me this 31st day of December, 19 53

My commission expires August 29, 1955

Dave Stuebel
Notary Public.

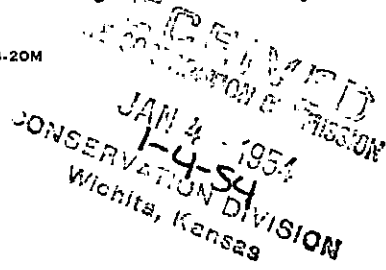

CONTRACTOR'S WELL LOG

COMPANY: Lion Oil Company
 CONTRACTOR: Musgrove Petroleum Corporation
 FARM: HOLLAND B #1
 LOCATION: NE SE NW
 Sec. 5-26-12, Pratt County, Kansas.
 COMMENCED: November 25, 1953
 COMPLETED: December 13, 1953

0	80	Surface soil & sand
80	220	Sand Rock
220	700	Red Bed
700	722	Anhydrite
722	1105	Shale
1105	1750	Shale & shells
1750	1940	Shale & lime streaks
1940	3950	Shale & lime
3950	3965	Lime
3965	4075	Lime & shale
4075	4164	Lime
4164	4200	Chat & lime
4200	4258	Lime, sand & shale
4258	4301	Shale
4301	4330	Arbuckle
	4330	RBTD

Set 8-5/8" surface pipe at 286' with 225 sacks cement.

D. & A

STATE OF KANSAS)
) SS
 COUNTY OF SEDGWICK)

I, GORDON L. KOELLING, do hereby certify that the above and foregoing is a true and correct copy of the log of the Holland B #1, NE SE NW, Section 5-26-12, Pratt County, Kansas, as reflected by the files of the Musgrove Petroleum Corporation.

MUSGROVE PETROLEUM CORPORATION

By *Gordon L. Koelling*
 Secretary-Treasurer

Subscribed and sworn to before me, a Notary Public, in and for Sedgwick County, Kansas, this 16th day of December, 1953.

William L. Stumpe
 Notary Public

My commission expires September 24, 1956.

PLUGGING
 FILE SEC 5 T 26 R (24)
 BOOK PAGE 2 LINE 10