

15-151-00329-0000

STATE OF KANSAS
STATE CORPORATION COMMISSION


WELL PLUGGING RECORD

OR
FORMATION PLUGGING RECORD

Strike out upper line
when reporting plug-
ging off formations.

Give All Information Completely
Make Required Affidavit
Mail or Deliver Report to:
Conservation Division
State Corporation Commission
800 Bittling Building
Wichita, Kansas

NORTH

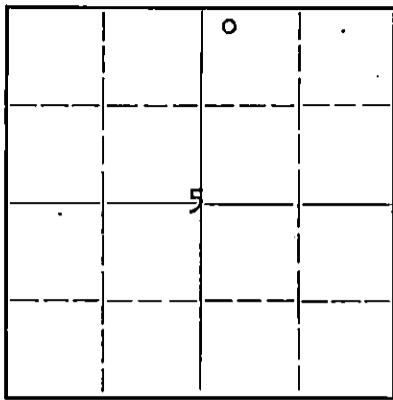

Locate well correctly on above
Section Plat

Pratt County, Sec. 5 Twp. 26S Rge. 12 (E) (W)

Location as "NE $\frac{1}{4}$ NW $\frac{1}{4}$ SW $\frac{1}{4}$ " or footage from lines C NW ten acres NW NE
Lease Owner Mercury Drilling Company
Lease Name Hawver Well No. 1
Office Address 1202 Hunt Building, Tulsa, Oklahoma
Character of Well (completed as Oil, Gas or Dry Hole) Dry Hole
Date well completed October 14, 1952
Application for plugging filed October 14, 1952
Application for plugging approved October 14, File 52-23 1952
Plugging commenced October 14, 1952
Plugging completed October 14, 1952
Reason for abandonment of well or producing formation Dry Hole

If a producing well is abandoned, date of last production 19
Was permission obtained from the Conservation Division or its agents before plugging was com-
menced? Yes - File 52 - 23

Name of Conservation Agent who supervised plugging of this well M. A. Rives, Box 148, Pratt, Kansas
Producing formation None Depth to top Bottom Total Depth of Well 4305 Feet
Show depth and thickness of all water, oil and gas formations.

OIL, GAS OR WATER RECORDS

CASING RECORD

Formation	Content	From	To	Size	Put In	Pulled Out
Lime, K.C.	Dry	(See Log Attached)		8-5/8"	256.54	None
Arbuckle	Dry	(See Log Attached)				

Describe in detail the manner in which the well was plugged, indicating where the mud fluid was placed and the method or methods used in introducing it into the hold. If cement or other plugs were used, state the character of same and depth placed, from _____ feet to _____ feet for each plug set.

Hole filled with heavy mud. Plug and 20 sacks cement at 250 feet.
Heavy mud to 35 feet, plug and 10 sacks cement at 35 feet.

RECEIVED
STATE CORPORATION COMMISSION
OCT 17 1952
10-17-52
CONSERVATION DIVISION
Wichita, Kansas

(If additional description is necessary, use BACK of this sheet)

Correspondence regarding this well should be addressed to Mercury Drilling Co.
Address 1202 Hunt Building, Tulsa, Oklahoma

STATE OF Oklahoma, COUNTY OF Tulsa, ss.
(employee of owner) or (owner or operator) of the above-described well,
being first duly sworn on oath, says: That I have knowledge of the facts, statements, and matters herein contained and the log of the above-described well as filed and that the same are true and correct. So help me God.

(Signature) H. H. Hook
1202 Hunt Building Tulsa, Oklahoma
(Address)

SUBSCRIBED AND SWORN to before me this 10 day of October, 1952
Elaine Louise Johnson Notary Public.


My commission expires August 10, 1953

19-4174



6-42-6M

PLUGGING
FILE SEC 5 T 26 R 12
BOOK PAGE 52 LINE 23

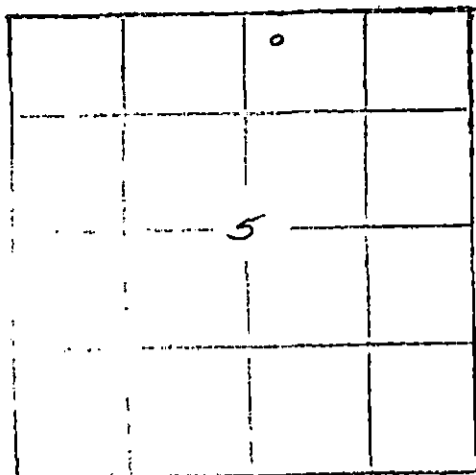

WELL RECORD

MERCURY DRILLING COMPANY

HAWVER NO. 1, C NW/4 NW/4 NE/4
SECTION 5-26S-12W
PRATT, COUNTY, KANSAS

CONTRACTOR: B & R DRILLING, INC.

DRILLING COMMENCED - SEPTEMBER 23, 1952

DRILLING COMPLETED - OCTOBER 13, 1952

ROTARY: 0' - 4305'

Section 5-26S-12W
Pratt County, Kansas

CASING RECORD:

Ran 8 Joints 256.54 feet - 8-5/8" - 28# - 8 thd. casing. Set at 254 feet with 250 sacks cement 3 sacks gel and 3 sacks calcium chloride. Plug down to 250 feet at 10:00 A.M. Cement circulated to cellar and settled back 42 feet. Ran 35 sacks cement and 1 sack calcium chloride on outside through 1 inch pipe.

FORMATION	TOP	BOTTOM	FORMATION	TOP	BOTTOM
Sand	0	165	Lime - K.C.	3655	3677
Shale and shells	165	712	Lime	3677	3736
Anhydrite	712	744	K.C. lime	3736	3762
Shale and shells	744	1120	Lime	3762	3915
Salt and shells	1120	1350	Lime and shale	3915	3952
Shale and shells	1350	1450	Shale and lime	3952	3970
Shale	1450	1610	Cherty lime	3970	3990
Lime	1610	2140	Shale and lime	3990	4014
Lime and shale	2140	2235	Shale and chert and lime	4014	4058
Shale and lime	2235	2380	Mississippi	4058	4066
Lime and shale	2380	3130	Shale	4066	4070
Lime	3130	3237	Viola	4070	4082
Lime and shale	3237	3278	Chert and lime	4082	4148
Lime	3278	3316	Lime	4148	4179
Lime and shale	3316	3380	Cherty lime and shale	4179	4215
Lime	3380	3434	Simpson sand	4215	4226
Lime and shale	3434	3560	Sand and shale	4226	4237
Shale and lime	3560	3609	Sandy shale	4237	4272
Brown lime	3609	3617	Arbuckle lime	4272	4287
Lime and shale	3617	3655	Arbuckle	4287	4305 T.D.

We hereby certify that the above is a true and correct record of the log on the Hawver No. 1 well located in the C NW/4 NW/4 NE/4 of Section 5-Township 26, South, Range 12 West, Pratt County, Kansas.

RECEIVED
STATE GEOLOGICAL
OCT 17 1952
10-17-52
CONSERVATION DIVISION
Wichita, Kansas

MERCURY DRILLING COMPANY

BY *Heleok*

PLUGGING
FILE SEC 5 T 26 R 12 W
BOOK PAGE 52 LINE 23