


15-151-10554-0000

STATE OF KANSAS
STATE CORPORATION COMMISSION

Give All Information Completely
Make Required Affidavit
Mail or Deliver Report to:
Conservation Division
State Corporation Commission
800 Bitling Building
Wichita, Kansas

WELL PLUGGING RECORD
OR
FORMATION PLUGGING RECORD

Strike out upper line
when reporting plug-
ging off formations.

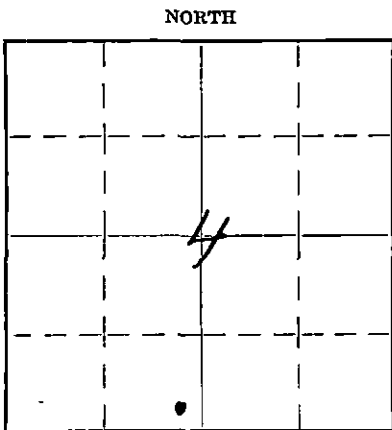

Locate well correctly on above
Section Plat

Pratt County. Sec. 4 Twp. 26 Rge. 12 (W)
Location as "NE $\frac{1}{4}$ NW $\frac{1}{4}$ SW $\frac{1}{4}$ " or footage from lines S. E. - SW. 420 E. L. 330 S. L.
Lease Owner. D. M. - Farnes
Lease Name. Lucas Well No. 1
Office Address. Lucas, Kansas
Character of Well (Completed as Oil, Gas or Dry Hole) D - A
Date, well completed. Nov. 11 - 1937 193.
Application for plugging filed. Nov 11 1937 193.
Application for plugging approved. 193.
Plugging Commenced. 11 - 13 - 37 193.
Plugging Completed. 11 - 13 - 37 193.
Reason for abandonment of well or producing formation. D - A
If a producing well is abandoned, date of last production. Nov 11 193.
Was permission obtained from the Conservation Division or its agents before plugging was commenced?

Name of Conservation Agent who supervised plugging of this well. C. J. Alexander
Producing formation. None Depth to top. X Bottom. X Total Depth of Well. 432.4 Feet.

Show depth and thickness of all water, oil and gas formations.


OIL, GAS OR WATER RECORDS

CASING RECORD

Formation	Content	From	To	Size	Put In	Pulled Out
<u>Surface sand</u>		<u>0</u>	<u>232</u>	<u>12 1/2</u>	<u>286</u>	<u>None</u>
<u>The above hole was cemented with 150 sacks</u>						
<u>cement</u>						

Describe in detail the manner in which the well was plugged, indicating where the mud fluid was placed and the method or methods used in introducing it into the hole. If cement or other plugs were used, state the character of same and depth placed, from _____ feet to _____ feet for each plug set.

Before starting out Breaking Down. Pits
were lined and made just as thick as
pump would handle sections dropped
to Bottom of pit and that heavy mud
circulated until got Return of heavy mud.
Hole was refilled. J. W. on trip out
1 Bag of Hay filled with Hay and 1 1/2 sacks of
Bottom Plug on top of Bag of Hay was Pushed
down to 286 ft with the Drill pipe and
15 Sacks cement on top of same.
1 Bag of Hay filled with Hay was Placed
at 14 ft from surface and 5 sacks cement
placed on top of same. Surface plug was
cut off at Bottom of cellar

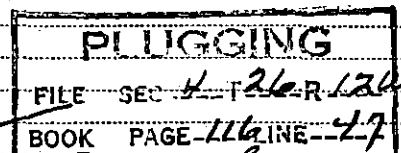

(If additional description is necessary, use BACK of this sheet)
Correspondence regarding this well should be addressed to Cecil A. Prather
Address. Offyville, Kansas

STATE OF Kansas COUNTY OF Sedgwick, ss.
Cecil A. Prather (employee of owner) or (owner or operator) of the above-described well,
being first duly sworn on oath, says: That I have knowledge of the facts, statements, and matters herein contained and the log of the above-described
well as filed and that the same are true and correct. So help me God.

(Signature) Cecil A. Prather
Offyville, Kansas (Address)

SUBSCRIBED AND SWORN TO before me this 16 day of November, 1937.

My commission expires April 23, 1941.

Effie J. Foote
Notary Public.