


STATE OF KANSAS
STATE CORPORATION COMMISSION

WELL PLUGGING RECORD

Give All Information Completely
Make Required Affidavit
Mail or Deliver Report to
Conservation Division
State Corporation Comm.
245 North Water
Wichita, KS 67202

Pratt County, Sec. 24 Twp. 26S Rge. 15W E/W
Location as "NE/CNW $\frac{1}{4}$ SW $\frac{1}{4}$ " or footage from lines
NW SW NW

Lease Owner Zenith Drilling Corporation
Lease Name Stotts #1 Well No. 1
Office Address Suite 505, Foruth Financial Center, Wichita, KS, 67202
Character of Well (Completed as Oil, Gas or Dry Hole)

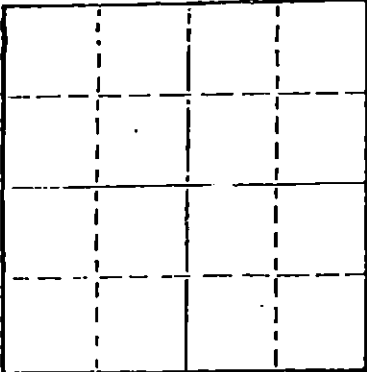

Locate well correctly on above
Section Plot

Dry Hole
Date Well completed March 12, 1980
Application for plugging filed March 12, 1980
Application for plugging approved March 12, 1980
Plugging commenced 1:30 PM, March 12, 1980
Plugging completed 3:30 PM, March 12, 1980
Reason for abandonment of well or producing formation

Dry Hole
If a producing well is abandoned, date of last production 19

Was permission obtained from the Conservation Division or its agents before plugging was commenced? Yes

Name of Conservation Agent who supervised plugging of this well Wm. T. Owen
Producing formation _____ Depth to top _____ Bottom _____ Total Depth of Well 4500'
Show depth and thickness of all water, oil and gas formations.

OIL, GAS OR WATER RECORDS

CASING RECORD

FORMATION	CONTENT	FROM	TO	SIZE	PUT IN	PULLED OUT
				8 5/8"	385'	None

Describe in detail the manner in which the well was plugged, indicating where the mud fluid was placed and the method or methods used in introducing it into the hold. If cement or other plugs were used, state the character of same and depth placed, from _____ feet to _____ feet for each plug set.

Filled hole with heavy mud.
Heavy mud to 390' with 50 sacks Pozmix through open ended drill pipe. Heavy mud to 40', 1/2 sack hulls, Howco plug, 10 sacks to surface, 5 sacks in rathole. Used 50/50 Pozmix with 3% gel.

(If additional description is necessary, use BACK of this sheet)

Name of Plugging Contractor Sterling Drilling Company, P. O. Box 129, Sterling, Kansas 67579

STATE OF KANSAS COUNTY OF RICE, ss.
F. A. Wuellner (employee of owner) or (owner or operator)

of the above-described well, being first duly sworn on oath, says: That I have knowledge of the facts, statements, and matters herein contained and the log of the above-described well as filed and that the same are true and correct. So help me God.

STERLING DRILLING COMPANY
(Signature) *F. A. Wuellner*
F. A. Wuellner, Secretary
P. O. Box 129, Sterling, Kansas 67579
(Address)

SUBSCRIBED AND SWORN TO before me this 13th day of March, 1980



My commission expires

Charles M. Hall
Charles M. Hall, Notary Public.
STATE OF KANSAS

MAR 18 1980
CONSERVATION DIVISION
Wichita, Kansas

STERLING DRILLING COMPANY
P. O. Box 129
Sterling, Kansas 67579

WELL LOG - - - - - STOTTS #1
Located: NW SW NW, Section 24-26S-15W, Pratt County, Kansas

OWNER: Zenith Drilling Corporation
ROTARY DRILLING CONTRACTOR: Sterling Drilling Company

COMMENCED: March 1, 1980
COMPLETED: March 12, 1980

TOTAL DEPTH: 4500'

LOG

0 - 98 Sand and Gravel
98 - 389 Sand and Clay
389 - 2130 Shale
2130 - 4065 Lime and Shale
4065 - 4270 Lime
4270 - 4370 Lime and Shale
4370 - 4491 Lime
4491 - 4500 Viola

CASING RECORD

Ran 9 joints 8 5/8", 23#, new casing.
374.52' pipe set at 385' K.B. Cemented
with 375 sacks 60/40 Pozmix with 3% cc.
Plug down at 8:30 AM, 3-2-80, by Howco.

Plugged.

Deviation Surveys: 1° at 2130'
1 1/2° at 4500'

RECEIVED
STATE CORPORATION COMMISSION

MAR 18 1980

CONSERVATION DIVISION
Wichita, Kansas