


WELL PLUGGING RECORD

All Information Completely
Required Affidavit
or Deliver Report to:
Conservation Division
State Corporation Commission
211 No. Broadway
Wichita, Kansas

Pratt County, Sec. 26 Twp. 26S Rge. (E) 15 (W)

Location as "NE/CNW&SW&" or footage from lines C/SE NW
Lease Owner Strata Drilling, Inc. & etal
Lease Name Curtis Well No. 1
Office Address P.OBox 355, Great Bend, Kansas
Character of Well (completed as Oil, Gas or Dry Hole) Dry Hole
Date well completed May 18 1963
Application for plugging filed May 18 1963
Application for plugging approved May 18 1963
Plugging commenced May 18 1963
Plugging completed May 18 1963
Reason for abandonment of well or producing formation Dry Hole

NORTH

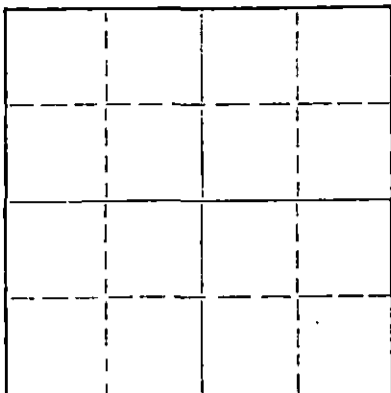

Locate well correctly on above
Section Plat

If a producing well is abandoned, date of last production 19
Was permission obtained from the Conservation Division or its agents before plugging was commenced? Yes

Name of Conservation Agent who supervised plugging of this well Archie Elving, Pratt, Kansas
Producing formation _____ Depth to top _____ Bottom _____ Total Depth of Well 910 Feet

Show depth and thickness of all water, oil and gas formations.

OIL, GAS OR WATER RECORDS

CASING RECORD

| FORMATION | CONTENT | FROM | TO | SIZE | PUT IN | PULLED OUT |
|-----------|---------|------|------|------|--------|------------|
| | 10-3/4" | 0' | 272' | | | |
| | | | | | | |
| | | | | | | |
| | | | | | | |
| | | | | | | |
| | | | | | | |
| | | | | | | |
| | | | | | | |
| | | | | | | |

Describe in detail the manner in which the well was plugged, indicating where the mud fluid was placed and the method or methods used in introducing it into the hole. If cement or other plugs were used, state the character of same and depth placed, from _____ feet to _____ feet for each plug set.

Hole plugged as follows: Plugged at 200' with 20 sacks of cement to 40'; plugged with 10 sacks of cement. Job completed at 6:30 P. M. May 18, 1963.

RECEIVED
STATE CORPORATION COMMISSION

MAY 23 1963

CONSERVATION DIVISION
Wichita, Kansas

(If additional description is necessary, use BACK of this sheet)

Name of Plugging Contractor Strata Drilling, Inc.
Address P. O. Box 355, Great Bend, Kansas

STATE OF KANSAS, COUNTY OF BARTON, ss.

Charles W. Steincamp (employee or owner) or (owner or operator) of the above-described well, being first duly sworn on oath, says: That I have knowledge of the facts, statements, and matters herein contained and the log of the above-described well as filed and that the same are true and correct. So help me God.

(Signature) Charles W. Steincamp
Charles W. Steincamp
P. O. Box 355, Great Bend, Kansas
(Address)

SUBSCRIBED AND SWORN to before me this 21st day of May, 1963

My commission expires December 14, 1965

Elaine H. Taylor
Elaine H. Taylor Notary Public.

D R I L L E R S L O G

#1 Curtis

| | | |
|----------------------------------------------------------|---------------------------------------|--------------------------------------------------------------------|
| CASING: 265' of used 10- 3/4" surface cas- ing. | COMPANY: Strata Drilling, Inc. & etal | DESCRIPTION: C/SE NW Section 26-26S-15W Pratt County, Kansas |
| TOTAL DEPTH: 910' | CONTRACTOR: Strata Drilling, Inc. | ELEVATION: 2038' GL |
| | COMMENCED: May 8, 1963 | |
| | COMPLETED: May 18, 1963 | |

D. & A.

| <u>FORMATION</u> | <u>FROM</u> | <u>TO</u> | <u>REMARKS</u> |
|------------------|-------------|-----------|---|
| Clay & Sand | 0 | 70 | Ran 265' of used 10-3/4" surface casing; set and cemented at 272' with 250 sacks of regular cement, 2% gel and 3% C. C., plug down at 12:45 A. M. 5-9-1953. Cement did not circulate. |
| Sand & Shale | 70 | 274 | |
| Red Bed & Shale | 274 | 910 | |

RECEIVED
STATE CORPORATION COMMISSION

MAY 23 1963

CONSERVATION DIVISION
Wichita, Kansas

D. & A.

Plugged hole as follows: Plugged at 200' with 20 sacks of regular cement to 40'; plugged with 10 sacks of cement. Job completed at 6:30 P. M. May 18, 1963.

STATE OF KANSAS)
) ss:
COUNTY OF BARTON)

I certify that this is a true and correct copy of the above log to the best of my knowledge.

STRATA DRILLING, INC.

Charles W. Steincamp
Charles W. Steincamp, President

Subscribed and sworn to before me this 21st day of May, 1963.

Elaine H. Taylor
Elaine H. Taylor, Notary Public

My Commission Expires:
December 14, 1965