


WELL PLUGGING RECORD

See All Information Completely
See Required Affidavit
File or Deliver Report to:
Conservation Division
State Corporation Commission
211 No. Broadway
Wichita, Kansas

Pratt County, Sec. 26 Twp. 26S Rge. (E) 15(W)

Location as "NE/CNW%SW%" or footage from lines Approx. C/SE NW
Lease Owner Strata Drilling, Inc. & etal
Lease Name Curtis Well No. 2
Office Address P. O. Box 355, Great Bend, Kansas
Character of Well (completed as Oil, Gas or Dry Hole) Dry Hole
Date well completed May 21 1963
Application for plugging filed May 21 1963
Application for plugging approved May 21 1963
Plugging commenced May 21 1963
Plugging completed May 21 5:30 A. M. 1963
Reason for abandonment of well or producing formation Dry Hole. Lost circ.
Hole bridged shut.

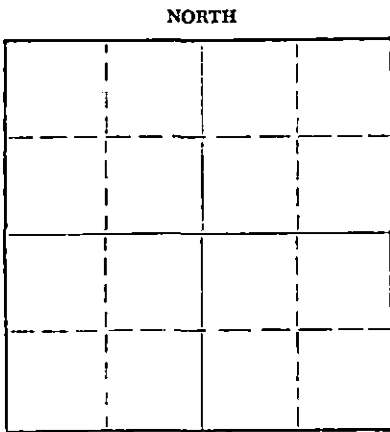

Locate well correctly on above
Section Plat

If a producing well is abandoned, date of last production _____ 19____
Was permission obtained from the Conservation Division or its agents before plugging was com-
menced? Yes

Name of Conservation Agent who supervised plugging of this well Archie Elving, Pratt, Kansas
Producing formation _____ Depth to top _____ Bottom _____ Total Depth of Well 787 Feet
Show depth and thickness of all water, oil and gas formations.

OIL, GAS OR WATER RECORDS

CASING RECORD

FORMATION	CONTENT	FROM	TO	SIZE	PUT IN	PULLED OUT
There was no casing set in this well.						

Describe in detail the manner in which the well was plugged, indicating where the mud fluid was placed and the method or methods used in introducing it into the hole. If cement or other plugs were used, state the character of same and depth placed, from _____ feet to _____ feet for each plug set.

Hole plugged as follows: Pumped cement through drill pipe, plugged at 100' with 50 sacks of cement and mud to 35'; plugged with 35 sacks of cement. Job completed at 5:30 A. M. May 21, 1963.

RECEIVED
STATE CORPORATION COMMISSION

MAY 24 1963

CONSERVATION DIVISION
Wichita, Kansas

(If additional description is necessary, use BACK of this sheet)

Name of Plugging Contractor Strata Drilling, Inc.
Address P. O. Box 355, Great Bend, Kansas

STATE OF KANSAS COUNTY OF BARTON, ss.
Charles W. Steincamp (employee of owner) or (owner or operator) of the above-described well, being first duly sworn on oath, says: That I have knowledge of the facts, statements, and matters herein contained and the log of the above-described well as filed and that the same are true and correct. So help me God.

(Signature) Charles W. Steincamp
Charles W. Steincamp
P. O. Box 355, Great Bend, Kansas
(Address)

SUBSCRIBED AND SWORN to before me this 22nd day of May, 1963

Elaine H. Taylor
Elaine H. Taylor Notary Public.

My commission expires December 14, 1965



D R I L L E R S L O G

#2 Curtis

CASING: None
COMPANY: Strata Drilling, Inc. & etal.
CONTRACTOR: Strata Drilling, Inc.
TOTAL DEPTH: 787'
COMMENCED: May 19, 1963
COMPLETED: May 21, 1963
D. & A.

DESCRIPTION: Approx. C/SE
NW Section 26-26S-15W
Pratt County, Kansas

<u>FORMATION</u>	<u>FROM</u>	<u>TO</u>	<u>REMARKS</u>
Sand	0	40	Drilled 787' of 12- $\frac{1}{4}$ " hole. Lost circ. Hole bridged over. Never could set surface casing.
Sand	40	190	
Shale & Red Bed	190	544	
Red Bed	544	787	

RECEIVED
STATE CORPORATION COMMISSION

MAY 24 1963

CONSERVATION DIVISION
Wichita, Kansas

D. & A.

Hole plugged as follows: Pumped cement through drill pipe, plugged at 100' with 50 sacks of cement and mud to 35'; plugged with 35 sacks of cement. Job completed at 5:30 A. M. May 21, 1963.

STATE OF KANSAS)
) ss:
COUNTY OF BARTON)

I certify that this is a true and correct copy of the above log to the best of my knowledge.

STRATA DRILLING, INC.

Charles W. Steincamp

Charles W. Steincamp, President

Subscribed and sworn to before me this 22nd day of May, 1963.

Elaine H. Taylor

Elaine H. Taylor, Notary Public

My Commission Expires:
December 14, 1965