

STATE OF KANSAS
STATE CORPORATION COMMISSION


Give All Information Completely
Make Required Affidavit
Mail or Deliver Report to:
Conservation Division
State Corporation Commission
211 No. Broadway
Wichita, Kansas

WELL PLUGGING RECORD

Pratt County, Sec. 28 Twp. 26 Rge. 15 (E) (W)

Location as "NE/CNW%SW%" or footage from lines NE NE NW
Lease Owner Santa Fe Pipe & Supply
Lease Name Tatlock # Well No. 1
Office Address Great Bend, Kansas
Character of Well (completed as Oil, Gas or Dry Hole) Oil
Date well completed 19
Application for plugging filed 19
Application for plugging approved 19
Plugging commenced October 17 19 61
Plugging completed October 22 19 61
Reason for abandonment of well or producing formation Depleted

NORTH

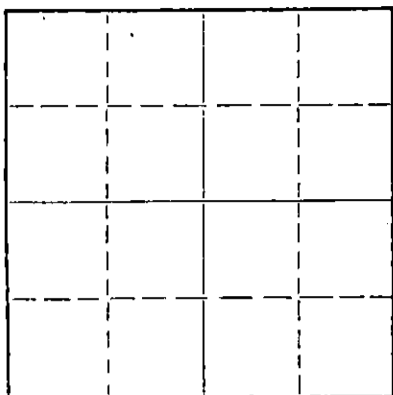

Locate well correctly on above
Section Plat

If a producing well is abandoned, date of last production 19
Was permission obtained from the Conservation Division or its agents before plugging was commenced? yes

Name of Conservation Agent who supervised plugging of this well Mr. Kackamp
Producing formation Depth to top Bottom Total Depth of Well Feet
Show depth and thickness of all water, oil and gas formations.

OIL, GAS OR WATER RECORDS

CASING RECORD

FORMATION	CONTENT	FROM	TO	SIZE	PUT IN	PULLED OUT
				8 5/8	325	
				5 1/2	4230	3416

Describe in detail the manner in which the well was plugged, indicating where the mud fluid was placed and the method or methods used in introducing it into the hole. If cement or other plugs were used, state the character of same and depth placed, from feet to feet for each plug set.

Sand to 3880'
55 sacks cement
Bailed hole to 300' and 10 rock bridge
Filled hole w/mud to 40' and 10' rock bridge
Capped well with 10 sacks cement

RECEIVED
STATE CORPORATION COMMISSION

JAN 21 1962

CONSERVATION DIVISION
Wichita, Kansas

(If additional description is necessary, use BACK of this sheet)

Name of Plugging Contractor Pipe Pullers Inc.
Address Ellinwood, Kansas

STATE OF Kansas, COUNTY OF Barton, ss.
Pipe Pullers Inc. (employee of owner) or (owner or operator) of the above-described well, being first duly sworn on oath, says: That I have knowledge of the facts, statements, and matters herein contained and the log of the above-described well as filed and that the same are true and correct. So help me God.

(Signature) Dean Steels

(Address)

SUBSCRIBED AND SWORN to before me this 25 day of October, 19 61

My commission expires December 18, 1961

Quanita R Myers Notary Public.



WELL LOG BUREAU - KANSAS GEOLOGICAL SOCIETY
508 East Murdock, Wichita, Kansas

Company ANSCHUTZ DRILLING CO., INC.
Farm Tatlock No. 1

SEC. 28 T. 26 R. 15W
NE NE NW

County Pratt

KANSAS



Total Depth. 4700
Comm. 9-24-54
Shot or Treated.
Contractor.
Issued. 1-1-55

Comp. 10-16-54

Elevation. 2050 DF

Production. 455 bbls.

CASING:

8 5/8 325' w/ 250 sx cmt.
5 1/2 @ 4230' w/ 125 sx cmt.

Figures indicate Bottom of Formations.

surface clay	35
sand	165
sand & shells	290
red rock	1010
anhydrite	1045
red rock, shale & shells	1460
shale, salt & shells	1750
shale, shells & red rock	1960
shale & shells	1985
lime	2745
shale & lime	3735
lime	3849
lime & shale	3978
lime	4215
shale & lime	4260
lime	4300
lime & shale	4328
Mississippi lime	4346
sand & shale	4370
shale & lime	4415
Viola lime	4500
shale & lime	4560
Viola chert	4580
lime & shale	4625
sand & shale	4650
lime & shale	4680
lime & Arbuckle	4690
Arbuckle	4700
Total Depth	

TOPS:

Heebner	3727
Brown lime	3884
Lansing-KC	3903
Base KC	4225
Mississippian	4322
Viola	4416
Simpson	4583
Shaley Arbuckle	4657
Arbuckle	4674

DST #1: 3906-40, open 1 hr. gas to surf. 4 min. rec. 570' free oil, IFP 520#, FFP 850#, BHP 1260#

DST #2: 4324-33, open 1 hr. weak to steady blow thru-out. rec. 10' mud, BHP 425#.

DST #3: 4660-80, open 1 hr. very weak blow, rec. 130' watery mud, NSO, BHP 1660#.

RECEIVED
STATE CORPORATION COMMISSION
JAN 24 1962
CONSERVATION DIVISION
Wichita, Kansas