


STATE OF KANSAS
STATE CORPORATION COMMISSION

WELL PLUGGING RECORD

Give All Information Completely
Make Required Affidavit
Mail or Deliver Report to
Conservation Division
State Corporation Comm.
245 North Water
Wichita, KS 67202

Pratt County. Sec. 19 Twp. 26S Rge. 15W E/W
Location as "NE/CNW $\frac{1}{4}$ SW $\frac{1}{4}$ " or footage from lines
SW SW SW

Lease Owner Beren Corporation, 970
Lease Name Bisel "A" #1 Well No. 1
Office Address 970 Fourth Financial Center, Wichita, Ks 67202
Character of Well (Completed as Oil, Gas or Dry Hole)

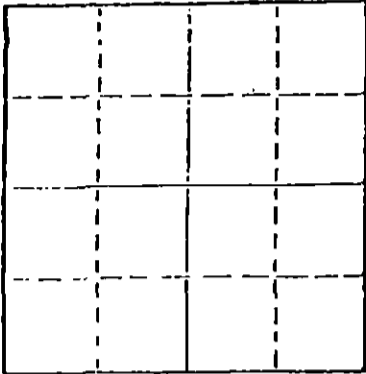

Locate well correctly on above
Section Plot

Dry Hole
Date Well completed June 18, 1981
Application for plugging filed June 18, 1981
Application for plugging approved June 18, 1981
Plugging commenced 8:00 PM June 18, 1981
Plugging completed 10:00 PM June 18, 1981
Reason for abandonment of well or producing formation

Dry Hole
If a producing well is abandoned, date of last production 19

Was permission obtained from the Conservation Division or its agents before plugging was commenced? Yes

Name of Conservation Agent who supervised plugging of this well Maurice Leslie
Producing formation _____ Depth to top _____ Bottom _____ Total Depth of Well 4500'
Show depth and thickness of all water, oil and gas formations.

OIL, GAS OR WATER RECORDS

CASING RECORD

FORMATION	CONTENT	FROM	TO	SIZE	PUT IN	PULLED OUT
				8 5/8"	463'	None

Describe in detail the manner in which the well was plugged, indicating where the mud fluid was placed and the method or methods used in introducing it into the hold. If cement or other plugs were used, state the character of same and depth placed, from _____ feet to _____ feet for each plug set.

Filled hole with heavy mud.
1st plug - heavy mud to 540', 50 sacks cement at 540'.
2nd plug - heavy mud to 460', 40 sacks cement at 460'.
Last plug - Solid bridge at 40' with 1/2 sack hulls,
Howco plug and 10 sacks cement to surface. 10 sacks
in rathole. Used 50/50 Pozmix with 4% gel and 3% cc

RECEIVED
STATE CORPORATION COMMISSION

JUN 25 1981


CONSERVATION DIVISION
Wichita, Kansas

(If additional description is necessary, use BACK of this sheet)
Name of Plugging Contractor Sterling Drilling Company, P. O. Box 129, Sterling, Kansas 67579

STATE OF KANSAS COUNTY OF RICE, ss.
E. A. Wuellner (employee of owner) or (owner or operator)
of the above-described well, being first duly sworn on oath, says: That I have knowledge of the facts, statements, and matters herein contained and the log of the above-described well as filed and that the same are true and correct. So help me God.

STERLING DRILLING COMPANY
(Signature) E. A. Wuellner
F. A. Wuellner, Secretary
P. O. Box 129, Sterling, Kansas 67579
(Address)

SUBSCRIBED AND SWORN TO before me this 22nd day of June, 1981.

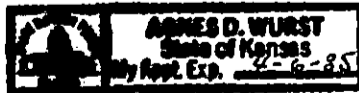

Agnes D. Wurst
Agnes D. Wurst, Notary Public.

My commission expires _____

STERLING DRILLING COMPANY
P. O. Box 129
Sterling, Kansas 67579

WELL LOG ----- BISEL "A" #1
Located: SW SW SW, Section 19-26S-15W, Pratt County,
Kansas

OWNER: Beren Corporation
ROTARY DRILLING CONTRACTOR: Sterling Drilling Company

COMMENCED: June 10, 1981
COMPLETED: June 18, 1981

TOTAL DEPTH: 4500'

<u>LOG</u>	<u>CASING RECORD</u>
0 - 300 Sand	Ran 12 joints 8 5/8", 20# OD casing.
300 - 1038 Shale	452.26' set at 463' K.B. Cemented with
1038 - 1056 Anhydrite	375 sacks 60/40 Pozmix with 3% cc. Plug
1056 - 1150 Shale	down at 6:45 PM, 6-10-81, by Howco.
1150 - 4417 Lime and Shale	
4417 - 4472 Lime	
4472 - 4500 Lime and Shale	Plugged.

Deviation Surveys: 1 1/2° at 2200'
1° at 4397'

RECEIVED
STATE CORPORATION COMMISSION

JUN 25 1981

CONSERVATION DIVISION
Wichita, Kansas