

STATE OF KANSAS
STATE CORPORATION COMMISSION


WELL PLUGGING RECORD

Give All Information Completely
Make Required Affidavit
Mail or Deliver Report to:
Conservation Division
State Corporation Commission
211 No. Broadway
Wichita, Kansas

Pratt County. Sec. 19 Twp. 26 Rge. 15 (X) (W)

Location as "NE/CNW/SW" or footage from lines NE/4 NW/4 SW/4
Lease Owner Twin Drilling, Inc.
Lease Name Bisel-Knowles Well No. 1
Office Address 1005 Central Bldg., Wichita, Kansas
Character of Well (completed as Oil, Gas or Dry Hole) Dry Hole
Date well completed 12-25 19 58
Application for plugging filed 12-29 19 58
Application for plugging approved 1- 5 19 59
Plugging commenced 12-25 19 58
Plugging completed 12-25 19 58
Reason for abandonment of well or producing formation Dry Hole

NORTH

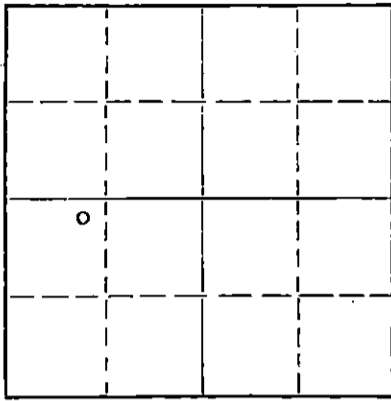

Locate well correctly on above
Section Flat

If a producing well is abandoned, date of last production 19
Was permission obtained from the Conservation Division or its agents before plugging was commenced? Yes

Name of Conservation Agent who supervised plugging of this well W. L. Lackamp, Stafford, Kansas
Producing formation Depth to top Bottom Total Depth of Well Feet
Show depth and thickness of all water, oil and gas formations.

OIL, GAS OR WATER RECORDS

CASING RECORD

FORMATION	CONTENT	FROM	TO	SIZE	PUT IN	PULLED OUT
				8 5/8"	409.87'	

Describe in detail the manner in which the well was plugged, indicating where the mud fluid was placed and the method or methods used in introducing it into the hole. If cement or other plugs were used, state the character of same and depth placed, from feet to feet for each plug set.

Filled hole with rotary mud to 300'. Set plug and

cement through drill pipe with 20 sacks cement.

Fill hole up to 35' of base of cellar. Set plug and

cap with 10 sacks cement.

(If additional description is necessary, use BACK of this sheet)

Name of Plugging Contractor Twin Drilling, Inc.
Address 1005 Central Building, Wichita, Kansas

STATE OF Kansas, COUNTY OF Sedgwick, ss.
C. R. Dunne (employee of owner) or (owner-or-operator) of the above-described well, being first duly sworn on oath, says: That I have knowledge of the facts, statements, and matters herein contained and the log of the above-described well as filed and that the same are true and correct. So help me God.

(Signature) *C. R. Dunne*
1005 Central Bldg., Wichita, Kansas
(Address)

SUBSCRIBED AND SWORN TO before me this 12 day of January, 19 59

My commission expires Sept. 9, 1961

RECEIVED
STATE CORPORATION COMMISSION

PLUGGING
FILE SEC 19 T 26 R 15 W
BOOK PAGE 9 LINE 45

JAN 13 1959
CONSERVATION DIVISION
Wichita, Kansas

