

STATE OF KANSAS  
STATE CORPORATION COMMISSION


WELL PLUGGING RECORD

Give All Information Completely  
Make Required Affidavit  
Mail or Deliver Report to:  
Conservation Division  
State Corporation Commission  
211 No. Broadway  
Wichita, Kansas

Pratt County. Sec. 27 Twp 26 S Rge. (E) 14 (W)

Location as "NE/CNW&SW&" or footage from lines. S/2 SE/4 NW/4  
Lease Owner Messman-Rinehart Oil Company  
Lease Name Berg "A"  
Office Address 1432 Wichita Plaza Bldg., Wichita, Kansas  
Character of Well (completed as Oil, Gas or Dry Hole) Dry Hole  
Date well completed April 23, 19 63  
Application for plugging filed April 23 19 63  
Application for plugging approved April 23 19 63  
Plugging commenced April 24 19 63  
Plugging completed April 24 19 63  
Reason for abandonment of well or producing formation Dry

NORTH

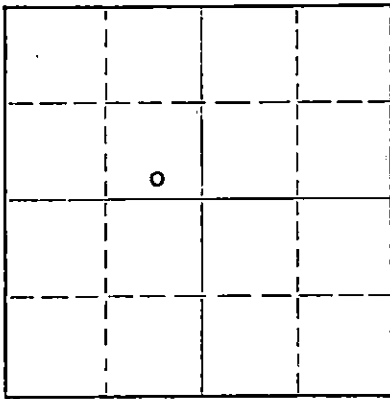

Locate well correctly on above  
Section Plat

If a producing well is abandoned, date of last production 19  
Was permission obtained from the Conservation Division or its agents before plugging was commenced? yes

Name of Conservation Agent who supervised plugging of this well Mr. Archie Elving, Box 652, Pratt, Kansas  
Producing formation Depth to top Bottom Total Depth of Well 4590 Feet  
Show depth and thickness of all water, oil and gas formations.

OIL, GAS OR WATER RECORDS

CASING RECORD

FORMATION	CONTENT	FRDM	TO	SIZE	PUT IN	PULLED OUT
				10-3/4"	275'	none

Describe in detail the manner in which the well was plugged, indicating where the mud fluid was placed and the method or methods used in introducing it into the hole. If cement or other plugs were used, state the character of same and depth placed, from feet to feet for each plug set.

Set bottom plug at 210 ft. with 1/4 sk. hulls  
and 25 sx. cement through drill pipe. Set top  
plug at 35 ft. with 1/4 sk. hulls and 13 sx.  
cement

RECEIVED  
STATE CORPORATION COMMISSION

MAY 13 1963

CONSERVATION DIVISION  
Wichita, Kansas

(If additional description is necessary, use BACK of this sheet)  
Name of Plugging Contractor Messman-Rinehart Oil Company  
Address 1432 Wichita Plaza Bldg., Wichita, Kansas

STATE OF Kansas, COUNTY OF Sedgwick, ss.  
J. A. Gilliland (employee of owner) of the above-described  
well, being first duly sworn on oath, says: That I have knowledge of the facts, statements, and matters herein contained and the log of the  
above-described well as filed and that the same are true and correct. So help me God.

(Signature) J. A. Gilliland  
1432 Wichita Plaza Bldg., Wichita, Kansas  
(Address)

SUBSCRIBED AND SWORN TO before me this 2nd day of May, 19 63  
Barbara J. Scott  
Notary Public.

My commission expires December 1, 1964



NO. 3 BENG "A"

Well Record:

<b>Location:</b>	S/2 SE/4 NW/4 Section 27-26S-14W Pratt County, Kansas	<b>Commenced:</b>	April 5, 1963
		<b>Completed:</b>	April 23, 1963
<b>Operator:</b>	Messman-Rinehart Oil Company 1432 Wichita Plaza Bldg. Wichita, Kansas	<b>Elevation:</b>	1985' K/B
		<b>Production:</b>	D & A
<b>Contractor:</b>	Messman-Rinehart Oil Company 1432 Wichita Plaza Bldg. Wichita, Kansas		

**Casing Record:** 10-3/4" @ 275' w/275 cu. cement.

\*\*\* LOG \*\*\*

Surface Clay	40
Sand and Clay	220
Red Bed Shale	275
Shale & Red Bed	540
Sand Streaks	660
Shale	920
Anhydrite	955
Shale & Shells	1140
Shale w/Lime Streaks	1700
Shale, Shells & Salt	1978
Lime	2125
Lime (chalky)	2259
Lime & Shale	2375
Lime	2665
Lime & Shale	3300
Lime	3720
Shale & Sand	3820
Shale	3865
Lime	4047
Lime w/chalk	4090
Lime	4176
Lime & Shale	4230
Lime & Chert	4258
Lime	4312
Conglomerate	4322
Lime - Mississippian	4327
Lime & Chert	4395
Lime, shale & Chert	4420
Lime (cherty)	4440
Lime Chert and Chalk	4475
Sand & ?	4485
Sand and Shale (Simpson)	4520
Shale & Sand	4537
Sand and Shale	4554
Arbuckle	4585
Lime	4590 R.T.D.

Sample Tops:

3244'	- Topeka (-1259)
3687'	- Heebner (-1702)
3846'	- Brown Lime (-1861)
3875'	- Lansing (-1890)
4304'	- Conglomerate (-2319)
4312'	- Mississippi (-2327)
4359'	- Viola (-2374)
4465'	- Simpson Shale (-2480)
4475'	- Simpson Sand (-2490)
4557'	- Arbuckle (-2572)

**RECEIVED**  
STATE CORPORATION COMMISSION

MAY 13 1963

CONSERVATION DIVISION  
Wichita, Kansas

The undersigned, MESSMAN-RINEHART OIL COMPANY, hereby certifies that the above log is a true and correct log of the formation encountered in drilling the above well as reflected by the Daily Drilling Reports.

MESSMAN-RINEHART OIL COMPANY

By: J. A. Gilliland

J. A. Gilliland

Subscribed and sworn to before me this  
2nd day of May, 1963

Barbara J. Scott  
Barbara J. Scott, Notary Public

My Commission Expires: December 1, 1964