


STATE OF KANSAS  
STATE CORPORATION COMMISSION  
CONSERVATION DIVISION  
P. O. BOX 17027  
WICHITA, KANSAS 67217

FORM CP-4

WELL PLUGGING RECORD

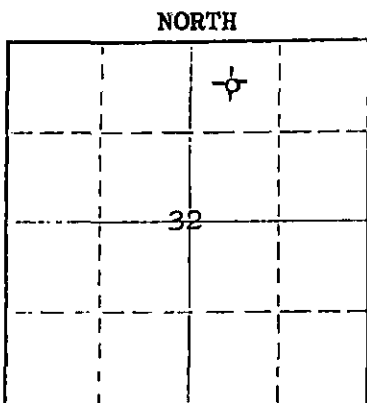

Locate well correctly on above Section Plot

Pratt County, Sec. 32 Twp 26S Rge 14W (W)  
Location as "NE/CNW&SW" or footage from lines. Approx. C NW NE  
Lease Owner National Oil Company  
Lease Name Berry Well No. 1  
Office Address 200 W. Douglas, Wichita, Kansas 67202  
Character of Well (completed as Oil, Gas or Dry Hole) Dry Hole  
Date well completed February 2, 1976  
Application for plugging filed February 2, 1976  
Application for plugging approved February 2, 1976  
Plugging commenced February 2, 1976  
Plugging completed February 2, 1976  
Reason for abandonment of well or producing formation Dry Hole

If a producing well is abandoned, date of last production 19\_\_  
Was permission obtained from the Conservation Division or its agents before plugging was commenced? Yes

Name of Conservation Agent who supervised plugging of this well \_\_\_\_\_  
Producing formation \_\_\_\_\_ Depth to top \_\_\_\_\_ Bottom \_\_\_\_\_ Total Depth of Well 4645 feet  
Show depth and thickness of all water, oil and gas formations.

OIL, GAS OR WATER RECORDS

CASING RECORD

FORMATION	CONTENT	FROM	TO	SIZE	PUT IN	FULLED OUT
		0'	779'	8-5/8"	779'	None

Describe in detail the manner in which the well was plugged, indicating where the mud fluid was placed and the method or methods used in introducing it into the hole. If cement or other plugs were used, state the character of same and depth placed, from \_\_\_\_\_ feet to \_\_\_\_\_ feet for each plug set.

35 sacks cement at 350', 15 sacks cement at 40',  
and 2 sacks cement in rat hole.

(If additional description is necessary, use BACK of this sheet)  
Name of Plugging Contractor Halliburton Cementing Co.  
Address Great Bend, Kansas

STATE OF KANSAS COUNTY OF SEDGWICK, ss.  
John D. Knightley, Agent (employee of owner) or (owner or operator) of the above-described well, being first duly sworn on oath, says: That I have knowledge of the facts, statements, and matters herein contained and the log of the above-described well as filed and that the same are true and correct. So help me God.

(Signature) *John D. Knightley*  
301 S. Broadway, Wichita, Kansas  
(Address)

SUBSCRIBED AND SWORN TO before me this 12th day of February, 1976

My commission expires March 12, 1979  
*Stella J. Lippa* Notary Public.

National Oil Company - Berry #1  
Approx. C NW NE Sec. 32-26S-14W  
Pratt County, Kansas

Contractor: D. R. Lauck Oil Company, Inc.  
301 S. Broadway  
Wichita, Kansas 67202

Commenced: January 20, 1976  
Completed: February 2, 1976

Drillers Log

Shale & Sand	265
Shale	608
Sand	628
Shale	1070
Shale with Lime Streaks	1735
Lime & Shale	2130
Shale & Lime	2350
Lime & Shale	2895
Shale	3115
Lime & Shale	3430
Shale & Lime	3620
Lime & Shale	3875
Lime	4340
Lime & Chert	4520
Lime & Shale	4585
Lime	4630
Arbuckle	4645 RTD

RECEIVED  
STATE COMMISSION COMMISSIONER

FEB 13 1976

CONSERVATION DIVISION  
Wichita, Kansas