

STATE OF KANSAS
STATE CORPORATION COMMISSION

WELL PLUGGING RECORD

Give All Information Completely
Make Required Affidavit
Mail or Deliver Report to:
Conservation Division
State Corporation Commission
800 Bitting Building
Wichita, Kansas

Pratt County, Sec. 33 Twp. 26 Rge. (E) 14(W)

Location as "NE/CNW/SW" or footage from lines. G - NW/4 NW/4 SE/4

Lease Owner Lion Oil Company

Lease Name Callahan Well No. 1

Office Address P. O. Box 639, Pratt, Kansas

Character of Well (completed as Oil, Gas or Dry Hole) Dry Hole

Date well completed 8- 5 19 52

Application for plugging filed 11-24 19 52

Application for plugging approved 11-25 19 52


Plugging commenced 12- 2 19 52

Plugging completed 12- 5 19 52

Reason for abandonment of well or producing formation Dry Hole

If a producing well is abandoned, date of last production 19

Was permission obtained from the Conservation Division or its agents before plugging was commenced? Yes

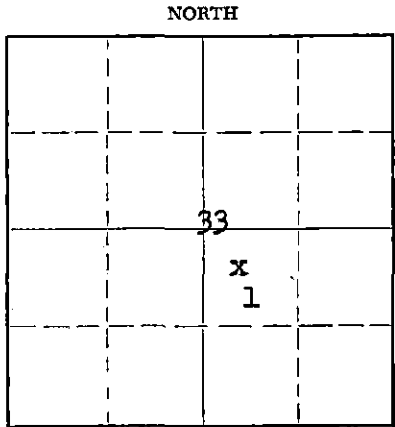

Locate well correctly on above Section Plat

Name of Conservation Agent who supervised plugging of this well Merle Rives

Producing formation Depth to top Bottom Total Depth of Well 4637 Feet

Show depth and thickness of all water, oil and gas formations. Plugged Back TD 3945 Feet

OIL, GAS OR WATER RECORDS

CASING RECORD

FORMATION	CONTENT	FROM	TO	SIZE	PUT IN	PULLED OUT
				8-5/8"	845'	0'
				5-1/2"	4432'	2731'

Describe in detail the manner in which the well was plugged, indicating where the mud fluid was placed and the method or methods used in introducing it into the hole. If cement or other plugs were used, state the character of same and depth placed, from feet to feet for each plug set.

Filled hole with sand from 3945' to 3920' and ran 5 sacks of cement. Mudded hole to 310', set 10' rock bridge and ran 20 sacks of cement at 300'. Mudded hole to 35', set rock bridge and ran 10 sacks of cement on top.

REC
STATE CORP COM
CONSERVATION DIVISION
Wichita, Kansas


Name of Plugging Contractor West Supply Company
Address Chase, Kansas

STATE OF KANSAS, COUNTY OF PRATT, ss.
Vernon Hayes (employee of owner) of the above-described well, being first duly sworn on oath, says: That I have knowledge of the facts, statements, and matters herein contained and the log of the above-described well as filed and that the same are true and correct. So help me God.

(Signature) *Vernon Hayes*
P. O. Box 639, Pratt, Kansas (Address)

SUBSCRIBED AND SWORN TO before me this 9th day of December, 19 52

My commission expires August 29, 1955 Notary Public.

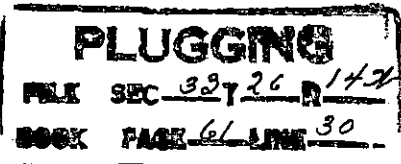

CALLAHAN WELL No. 1

NW-NW-SE
Sec. 33-26S-14W
PRATT COUNTY, KANSAS

CONTRACTOR: THE R. W. RINE DRILLING COMPANY
STARTED: JULY 3, 1952 FINISHED: JULY 22, 1952

SURFACE SAND AND SHALE	0	-	250	
RED BED	250	-	720	SYFO @ 500' - 1/2°
SHALE AND SHELLS	720	-	845	
LIME	845	-	855	8-5/8" Csg. @ 845' w/625 sx. COMMON w/1/2# FLO-CELE PER SX. w/6 sx. C.C.
RED BED, SHALE	855	-	1480	SYFO @ 1000' - 1°
SHALE AND SHELLS	1480	-	1885	SYFO @ 1500' - 1°
LIME	1885	-	2360	SYFO @ 2000' - 1/2°
LIME AND SHALE	2360	-	2505	SYFO @ 2500' - 1/2°
LIME	2505	-	2597	
LIME AND SHALE	2597	-	2890	
SHALE AND SHELLS	2890	-	3025	SYFO @ 3000' - OK
LIME AND SHALE	3025	-	3225	
LIME AND SHALE	3225	-	3505	
LIME	3505	-	3665	SYFO @ 3635' - 1/2°
LIME AND SHALE	3665	-	3945	
LIME	3945	-	4315	
LIME AND CHERT	4315	-	4416	
LIME	4416	-	4465	
CHERT	4465	-	45000	
LIME, SHALE AND SAND	4500	-	4535	
SAND AND SHALE	4535	-	4560	
LIME AND SHALE	4560	-	4610	
LIME	4610	-	4640	RTD. 5 1/2" Csg. @ 4440' w/250 sx. COMMON CEMENT, JULY 22, 1952.

I, R. M. GREEN, DO HEREBY CERTIFY THAT THE ABOVE IS A TRUE AND ACCURATE LOG OF THE CALLAHAN WELL No. 1, LOCATED NW, NW, SE, SECTION 33-26S-14W, PRATT COUNTY, KANSAS.

R. M. Green
ASSISTANT SECRETARY

SUBSCRIBED TO AND SWORN BEFORE ME THIS 25TH DAY OF JULY, 1952.

Louise Pederson
NOTARY PUBLIC

MY COMMISSION EXPIRES APRIL 20, 1955.

RECEIVED
STATE CONSERVATION COMMISSION
FEB 20 1953
CONSERVATION DIVISION
Wichita, Kansas

PLUGGING
FILE SEC 33 T 26 R 142
BOOK PAGE 61 LINE 30