


15-035-19553-00-00

STATE OF KANSAS
STATE CORPORATION COMMISSION

WELL PLUGGING RECORD

Give All Information Completely
Make Required Affidavit
Mail or Deliver Report to:
Conservation Division
State Corporation Commission
800 Biting Building
Wichita, Kansas

COWLEY County. Sec. 17 Twp. 33 Rge. 3 (E) E (W)
Location as "NE/CNW/SW" or footage from lines NE NE SE

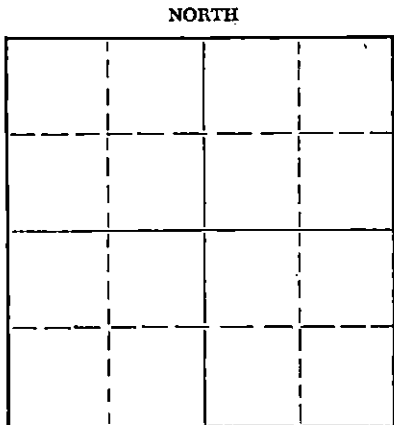

Locate well correctly on above
Section Plat

Lease Owner Meade Production
Lease Name Watts Well No. 1
Office Address 410 Thompson Bldg., Tulsa, Oklahoma
Character of Well (completed as Oil, Gas or Dry Hole) _____
Date well completed _____ 19____
Application for plugging filed _____ 12-2 19 54
Application for plugging approved _____ 19____
Plugging commenced _____ 12-4 19 54
Plugging completed _____ 12-11 19 54
Reason for abandonment of well or producing formation _____

If a producing well is abandoned, date of last production _____ 19____
Was permission obtained from the Conservation Division or its agents before plugging was commenced? Yes.

Name of Conservation Agent who supervised plugging of this well W. L. Lemaster
Producing formation _____ Depth to top _____ Bottom _____ Total Depth of Well 3216 Feet
Show depth and thickness of all water, oil and gas formations.

OIL, GAS OR WATER RECORDS

CASING RECORD

FORMATION	CONTENT	FROM	TO	SIZE	PUT IN	PULLED OUT
				5"		2349

Describe in detail the manner in which the well was plugged, indicating where the mud fluid was placed and the method or methods used in introducing it into the hole. If cement or other plugs were used, state the character of same and depth placed, from _____ feet to _____ feet for each plug set.

Cement	3216	3156
Mud	3156	155
Rock	155	145
Cement	145	105
Mud	105	35
Cement	35	0

Cap with Steel Plate.

RECEIVED
STATE CORPORATION COMMISSION
NOV 13 1955
CONSERVATION DIVISION
WICHITA, KANSAS

(If additional description is necessary, use BACK of this sheet)
Name of Plugging Contractor V. W. McKnab
Address 1117 Millington, Winfield, Kansas

STATE OF Oklahoma COUNTY OF Tulsa, SS.
R. L. Blackwell (employee of owner) or (owner or operator) of the above-described well, being first duly sworn on oath, says: That I have knowledge of the facts, statements, and matters herein contained and the log of the above-described well as filed and that the same are true and correct. So help me God.

(Signature) R. L. Blackwell
410 Thompson Bldg Tulsa Okla
(Address)

SUBSCRIBED AND SWORN TO before me this 21 day of December, 1954

My commission expires August 2, 1956
Margaret H. Voltz Notary Public.

PLUGGING
FILE NO. 15-035-19553-00-00
BOOK 69 PAGE 13

15-035-19553-00-00

Watts Well No.1
NE NE SE Sec.17-33S-3E
Cowley County, Kansas

0	50	sand	10 3/4"	casg.	100'
50	100	shale & shells	5 1/2"	"	3200'
100	475	lime & shale			
475	1435	shale & shells			
1435	2155	lime & shale			
2155	2290	shale & sandstone			
2290	2360	lime & shale			
2360	2505	lime & sandy shale			
2505	2561	shale			
2561	2625	sand & shale			
2625	2730	shale & sandy lime			
2730	2820	lime			
2820	3070	lime & shale			
3070	3176	shale & lime			
3176	3179	sand-Bartlesville			
3179	3185	sand-stain & odor			
3185	3185 1/2	shale black			
3185 1/2	3201	lime-Mississippi TD			

RECEIVED
STATE CORPORATION COMMISSION
JAN 7 1955
CONSERVATION DIVISION
Wichita, Kansas

PLUGGING
FILE SEC 17-33-3E
BOOK PAGE 24 LINE 13