


STATE OF KANSAS  
STATE CORPORATION COMMISSION

WELL PLUGGING RECORD

Give All Information Completely  
Make Required Affidavit  
Mail or Deliver Report to  
Conservation Division  
State Corporation Comm.  
245 North Water  
Wichita, KS 67202

Pratt County. Sec. 27 Twp. 26S Rge. 12W E/W  
Location as "NE/CNW $\frac{1}{4}$ SW $\frac{1}{4}$ " or footage from lines \_\_\_\_\_  
C SW NE  
Lease Owner Wayne Walcher  
Lease Name Strong Well No. 1  
Office Address 701 Bitting Building, Wichita, Kansas 67202  
Character of Well (Completed as Oil, Gas or Dry Hole) \_\_\_\_\_

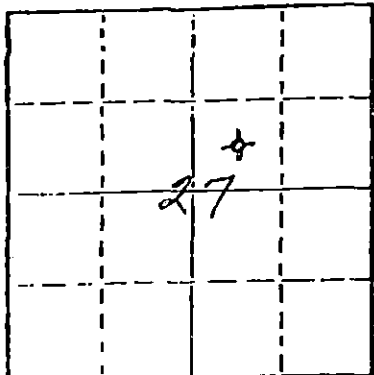

Locate well correctly on above  
Section Plot

Dry Hole  
Date Well completed August 7, 1981  
Application for plugging filed August 7, 1981  
Application for plugging approved August 7, 1981  
Plugging commenced August 7, 1981  
Plugging completed August 7, 1981  
Reason for abandonment of well or producing formation \_\_\_\_\_

Dry Hole  
If a producing well is abandoned, date of last production 19 \_\_\_\_\_

Was permission obtained from the Conservation Division or its agents before plugging was commenced? Yes \_\_\_\_\_

Name of Conservation Agent who supervised plugging of this well Wm. T. Owen  
Producing formation \_\_\_\_\_ Depth to top \_\_\_\_\_ Bottom \_\_\_\_\_ Total Depth of Well 4324'  
Show depth and thickness of all water, oil and gas formations.

OIL, GAS OR WATER RECORDS

CASING RECORD

FORMATION	CONTENT	FROM	TO	SIZE	PUT IN	PULLED OUT
		0'	383'	8-5/8"	376.24'	None

Describe in detail the manner in which the well was plugged, indicating where the mud fluid was placed and the method or methods used in introducing it into the hold. If cement or other plugs were used, state the character of same and depth placed, from \_\_\_\_\_ feet to \_\_\_\_\_ feet for each plug set.

Plugged with 50 sacks cement at 520';  
40 sacks cement at 380'; 10 sacks cement at 40';  
and 10 sacks cement in rat hole.

(If additional description is necessary, use BACK of this sheet).

Name of Plugging Contractor Allied Cementing Co.

STATE OF KANSAS COUNTY OF SEDGWICK, ss.  
John H. Knightley Agent (employee of owner) or (owner or operator)  
of the above-described well, being first duly sworn on oath, says: That I have knowledge of the facts, statements, and matters herein contained and the log of the above-described well as filed and that the same are true and correct. So help me God.

(Signature) John H. Knightley  
221 S. Broadway, Suite 400, Wichita, KS 67202  
(Address)

SUBSCRIBED AND SWORN TO before me this 20th day of August, 1981

My commission expires March 12, 1983

RECEIVED  
STATE CORPORATION COMMISSION  
AUG 24 1981  
8-24-81  
CONSERVATION DIVISION  
Wichita Kansas



Wayne Walcher  
701 Bitting Building  
Wichita, Kansas 67202

-

Strong #1  
C SW NE Sec. 27-26S-12W  
Pratt County, Kansas

Contractor: D. R. Lauck Oil Company, Inc.  
221 S. Broadway, Suite 400  
Wichita, Kansas 67202

Commenced: July 28, 1981  
Completed: August 7, 1981

Drillers Log

Sand	200
Red Bed	950
Shale	1404
Anhydrite	1408
Shale & Shells	2730
Shale & Lime	3710
Lime & Shale	4140
Lime	4324 RTD

RECEIVED  
STATE CORPORATION COMMISSION

AUG 24 1981  
8-24-81  
CONSERVATION DIVISION  
Wichita, Kansas