


5-151-10591-0000

STATE OF KANSAS
STATE CORPORATION COMMISSION

WELL PLUGGING RECORD

Give All Information Completely
Make Required Affidavit
Mail or Deliver Report to:
Conservation Division
State Corporation Commission
800 Biting Building
Wichita, Kansas

NORTH

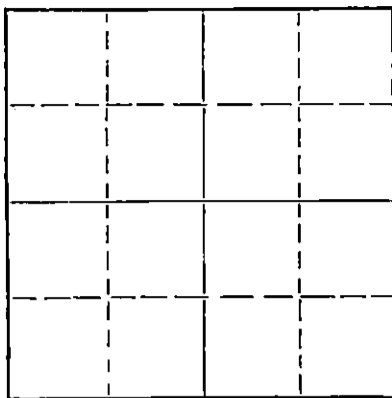

Locate well correctly on above
Section Plat

PRATT County. Sec. 20 Twp. 26 Rge. (E) 1 (W) 1
Location as "NE/CNW%SW%" or footage from lines C SW/4 SW/4
Lease Owner ALADDIN PETROLEUM CORP.
Lease Name HOEME Well No. 1
Office Address 809 PETROLEUM BLDG., WICHITA, KS.
Character of Well (completed as Oil, Gas or Dry Hole) OIL
Date well completed MARCH 4 19 56
Application for plugging filed FEB. 17 19 56
Application for plugging approved " 17 19 56
Plugging commenced " 24 19 56
Plugging completed " 27 19 56
Reason for abandonment of well or producing formation NOT PROFITABLE

If a producing well is abandoned, date of last production FEB. 19 56
Was permission obtained from the Conservation Division or its agents before plugging was commenced? YES

Name of Conservation Agent who supervised plugging of this well M. A. RIVES
Producing formation _____ Depth to top _____ Bottom _____ Total Depth of Well 4309 Feet
Show depth and thickness of all water, oil and gas formations. P.B. 3944

OIL, GAS OR WATER RECORDS

CASING RECORD

FORMATION	CONTENT	FROM	TO	SIZE	PUT IN	PULLED OUT
				10 3/4	155	NONE
				5 1/2	4297	3163

Describe in detail the manner in which the well was plugged, indicating where the mud fluid was placed and the method or methods used in introducing it into the hole. If cement or other plugs were used, state the character of same and depth placed, from _____ feet to _____ feet for each plug set.

T.D.	TO 3820	5 SAX CEMENT
3820	TO 2795	MUDDED
2795	TO 300	"
300	TO 285	ROCK BRIDGE
285	TO 260	25 SAX CEMENT
260	TO 30	MUDDED
30	TO CELLAR	10 SAX CEMENT

(If additional description is necessary, use BACK of this sheet)

Name of Plugging Contractor Ross PIPE PULLING CO.
Address ELLINWOOD, KANSAS

STATE OF KANSAS, COUNTY OF SEDGWICK, ss.
_____(employee of owner) or (owner or operator) of the above-described well, being first duly sworn on oath, says: That I have knowledge of the facts, statements, and matters herein contained and the log of the above-described well as filed and that the same are true and correct. So help me God.

(Signature) J. M. JOHNSON
809 PETROLEUM BLDG. (Address)
WICHITA, KANS. MARCH 19 56

SUBSCRIBED AND SWORN to before me this 8TH day of _____, 19 56

My commission expires Nov - 1 - 1957
Jaye English
Notary Public.

PLUGGING
FILE SEC 20 T 26 R 12W
BOOK PAGE 39 LINE 21

3-14-56
CONSERVATION DIVISION
Wichita, Kansas

15-151-10591-0000

COMPANY: Aladdin Petroleum Corporation
 CONTRACTOR: Tri-State Drilling Co., Inc.
 FARM: Hoops Well No. 1

LOCATION: SW/4 SW/4
 Section 20-26-12W
 Pratt County, Kansas

COMMENCED: November 4, 1943
 COMPLETED: December 12, 1943
 (Fill-up Test)
 ELEVATION: 1907'
 PRODUCTION: 87 B/D POTENTIAL 3/4/44

CASING RECORD:
 10 5/4" 766' - 426 sax
 6 1/2" 4297' - 200 sax
 TOTAL DEPTH: 4309' (S.L.M.)
 PFB# 3944 PERR. 3832-3933

FORMATION	DEPTH	FORMATION	DEPTH
Surface hole & clay	25	Chert	4106
Sand	140	Chert streaks & shale	4150
Red bed and sand	200	Chert	4163
Red bed	555	Detritus	4165
Shale and shells	690	Lime	4174
Red bed - shells	743	Shale and sand shells	4206
Anhydrite	790	Fine Dolomite sand	4214
Red bed - shale	860	Sand	4231
Shale and Red Bed	1220	Sand & shale	4256
Salt and Shale	1540	Shale and lime	4300
Shale and shells	1800		
Lime and shale	2055	TOTAL DEPTH	4300
Sandy lime	2045		(Rotary Measure)
Lime	2090		
Lime and shale	2270	Top Arbuckle	4294
Shale - lime	2280		(Rotary measure)
Lime and shale	2485	5 1/2" cemented "	4297
Shale and shells	2575		(Rotary measure)
Shale and lime	2865		
Lime and shale	3155	Perdue-Haskin Cardwell Unit moved	
Lime	3438	in December 12, 1943. Drilled in	
Lime and shale	3475	to 4311' (Corrected 4309 S.L.M.)	
Lime	3500	(Derrick floor). Fill-up tested	
Shale and lime	3525	2800' oil in 24 hours.	
Shale and shells	3615		
Lime and shale	3660		
Lime	3790	PERNA	3155'
Cherty lime	3825	LANSING	3658
Lime	3965	VIOLA	4090
Lime and shale	3995	IMPSON	4174
Shale and shells	4055	ARBUCKLE	4294
Lime and chert streaks	4075		
Cherty shale	4090		

I hereby certify this to be a correct and accurate log of the above described well as shown by the drilling reports

[Signature]

Subscribed and sworn to before me this 21st day of February, 1944

[Signature]
 Notary Public

My Commission expires December 8, 1945

PLUGGING
 FILE SEC 20-26-R-12W
 BOOK PAGE 39 LINE 21

RECEIVED
 STATE OF KANSAS
 DEPARTMENT OF REVENUE
 JAN 14 1944
 3-14-56
 INSURANCE DIVISION
 Topeka, Kansas