

STATE OF KANSAS
STATE CORPORATION COMMISSION

Give All Information Completely
Make Required Affidavit
Mail or Deliver Report to:
Conservation Division,
State Corporation Commission,
800 Bittling Building,
Wichita, Kansas.

WELL PLUGGING RECORD

OR

FORMATION PLUGGING RECORD

Strike out upper line
when reporting plugging
of formations.

pd.
1/4/38
na

NORTH

Locate well correctly on above
640 A. Plat

Pratt County. Sec. 20 Twp. 26S Rge. 12 E (W)

Lease Name. Hoeme **WELL NO. 1**
 Lease Owner. Helmerich & Payne, Inc.,
 Office Address. 1702 Philtower, Tulsa, Oklahoma
 Character of Well (Oil, Gas or Dry) Dry Total Depth of Well. 4470 Feet
 Date, well, completed. January 1 1938
 Application for plugging and log of well filed. January 1 1938
 Application for plugging approved. January 1 1938
 Plugging Commenced. January 1 1938
 Plugging Completed. January 1 1938
 Reason for abandonment of well or producing formation. Dry hole

If a producing well is abandoned, date of last production. 193
 Was permission obtained from the Conservation Division or its agents before plugging was commenced? Yes

Name of Conservation Officer who supervised plugging of this well. C. T. Alexander
 Producing formation. _____ Depth to top. _____ Bottom _____

Show depth and thickness of all water, oil and gas formations.

OIL, GAS OR WATER RECORDS


CASING RECORD

Formation	Content	From	To	Size	Put In	Pulled Out

Describe in detail the manner in which the well was plugged, indicating where the mud fluid was placed and the method or methods used in introducing it into the hole. If cement or other plugs were used, state the character of same and depth placed, from 432 feet to 442 feet for each plug set.

Ran drill pipe in and filled hole with heavy mud.
Spotted cement in bottom of surface casing and welded top of surface. 10" surface casing was cemented with 420 sacks of cement at 442 feet.
Cellar and pits will be levelled immediately

pd.
1/4/38
na

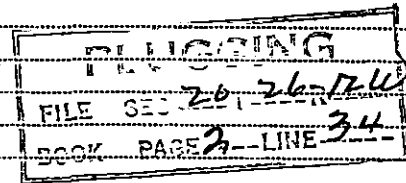

(If additional description is necessary use BACK of this sheet)

Does the above conform strictly to the Conservation Division regulations? Yes
 Was exception made? _____ If so describe _____

Correspondence regarding this well should be addressed to Helmerich & Payne, Inc.,
 Address 1702 Philtower, Tulsa, Oklahoma

STATE OF Oklahoma, COUNTY OF Tulsa, ss.

C. M. Copeland (employee of owner) of the above-described well,
 being first duly sworn on oath, says: That I have knowledge of the facts, statements, and matters herein contained and the log of the above-described well as filed and that the same are true and correct. So help me God.

(Signature) C M Copeland

1702 Philtower, Tulsa, Oklahoma
 (Address)

SUBSCRIBED AND SWORN to before me this 12th day of January, 1938.

My commission expires May 20, 1938 Notary Public.